



50423

33-7-27

# T. 33 S., R. 7 W. W.M. NW 1/4, SW 1/4, SEC. 27

PREPARED BY:  
JONATHAN C. SPERO W.R.E. 123  
1002 KINCAID RD./P.O. BOX 16  
WILLIAMS, OREGON 97544  
PHONE (503) 846-6845

THIS MAP IS FOR THE PURPOSE OF IDENTIFYING THE LOCATION OF THE WATER RIGHT ONLY AND IS NOT INTENDED TO PROVIDE LEGAL DIMENSIONS OR LOCATIONS OF PROPERTY OWNERSHIP LINES.

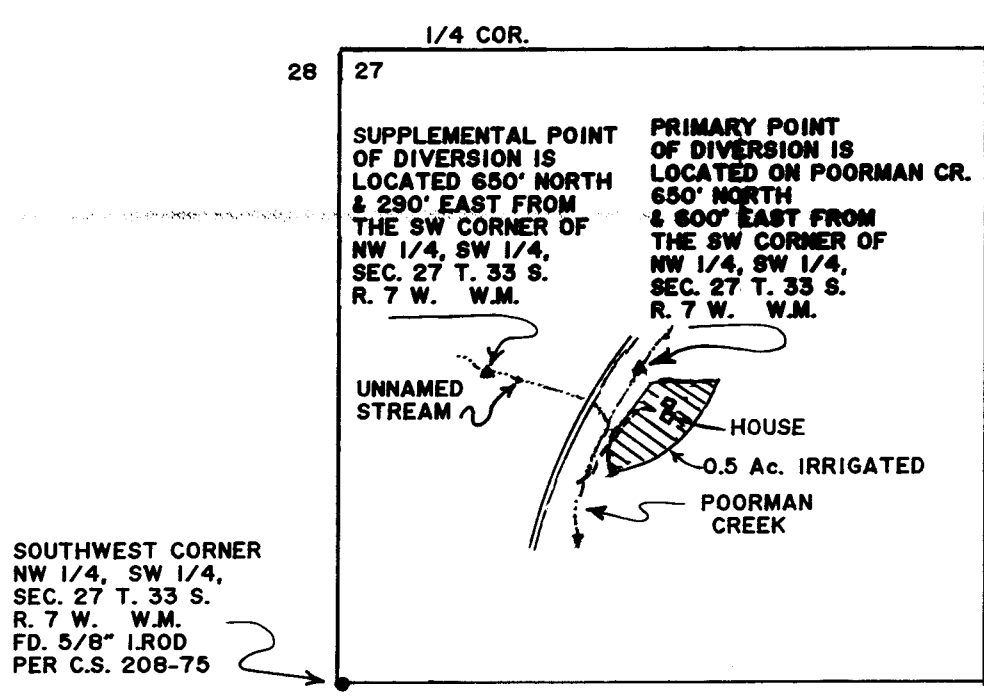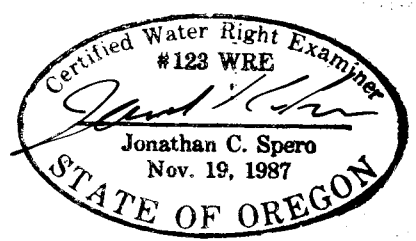

SCALE: 1" = 400'

## FINAL PROOF SURVEY UNDER

Application No. 69696 Permit No. 50423

IN NAME OF  
EILEEN J. SEYLER

Surveyed 03 / 08, 19 91 by JONATHAN C. SPERO