


Range 6 W. W.M.

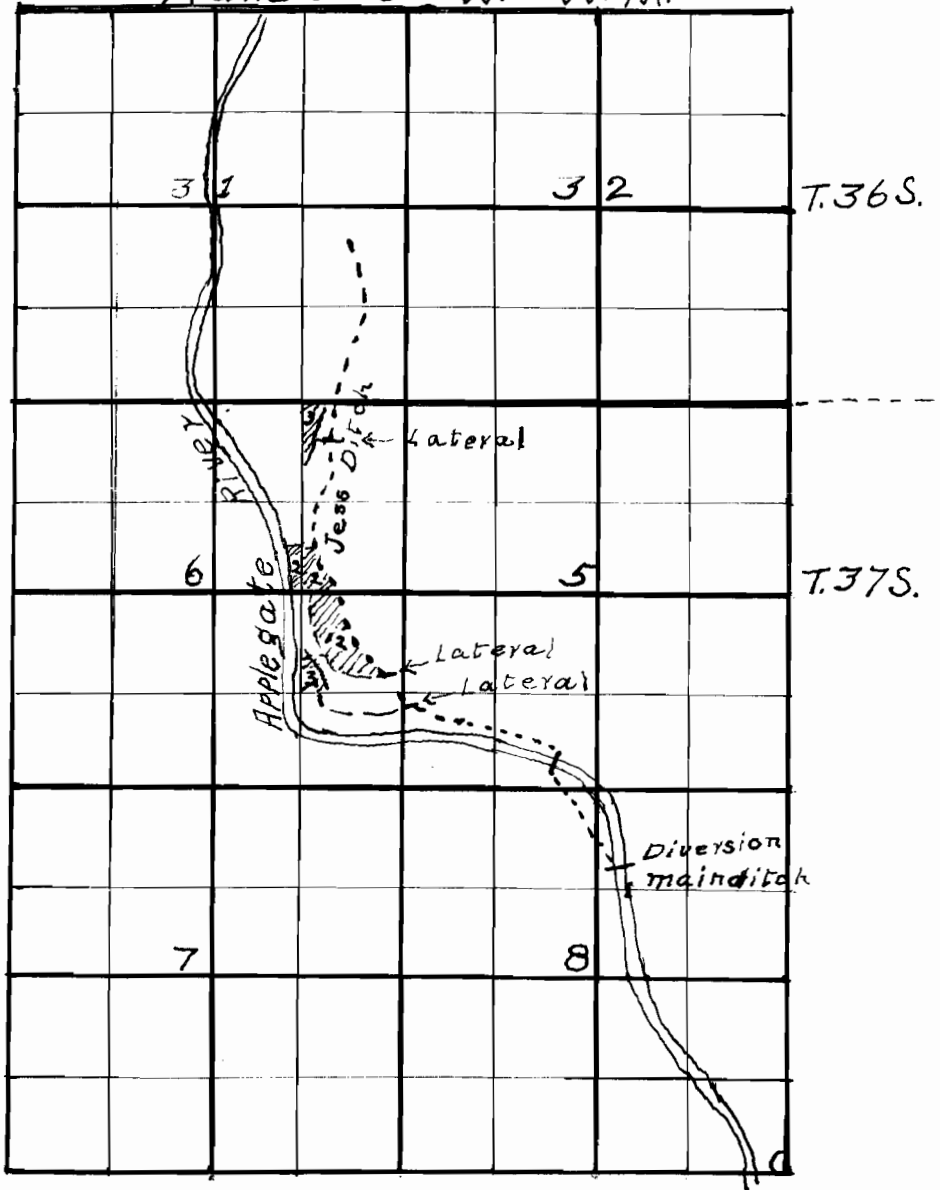

Applegate No. 785/
Permit No. 5050