


Section 1 Township 4S Range 2W W.M.
 Yamhill County

NW Corner
 Section 1

N1/4 Corner
 Section 1

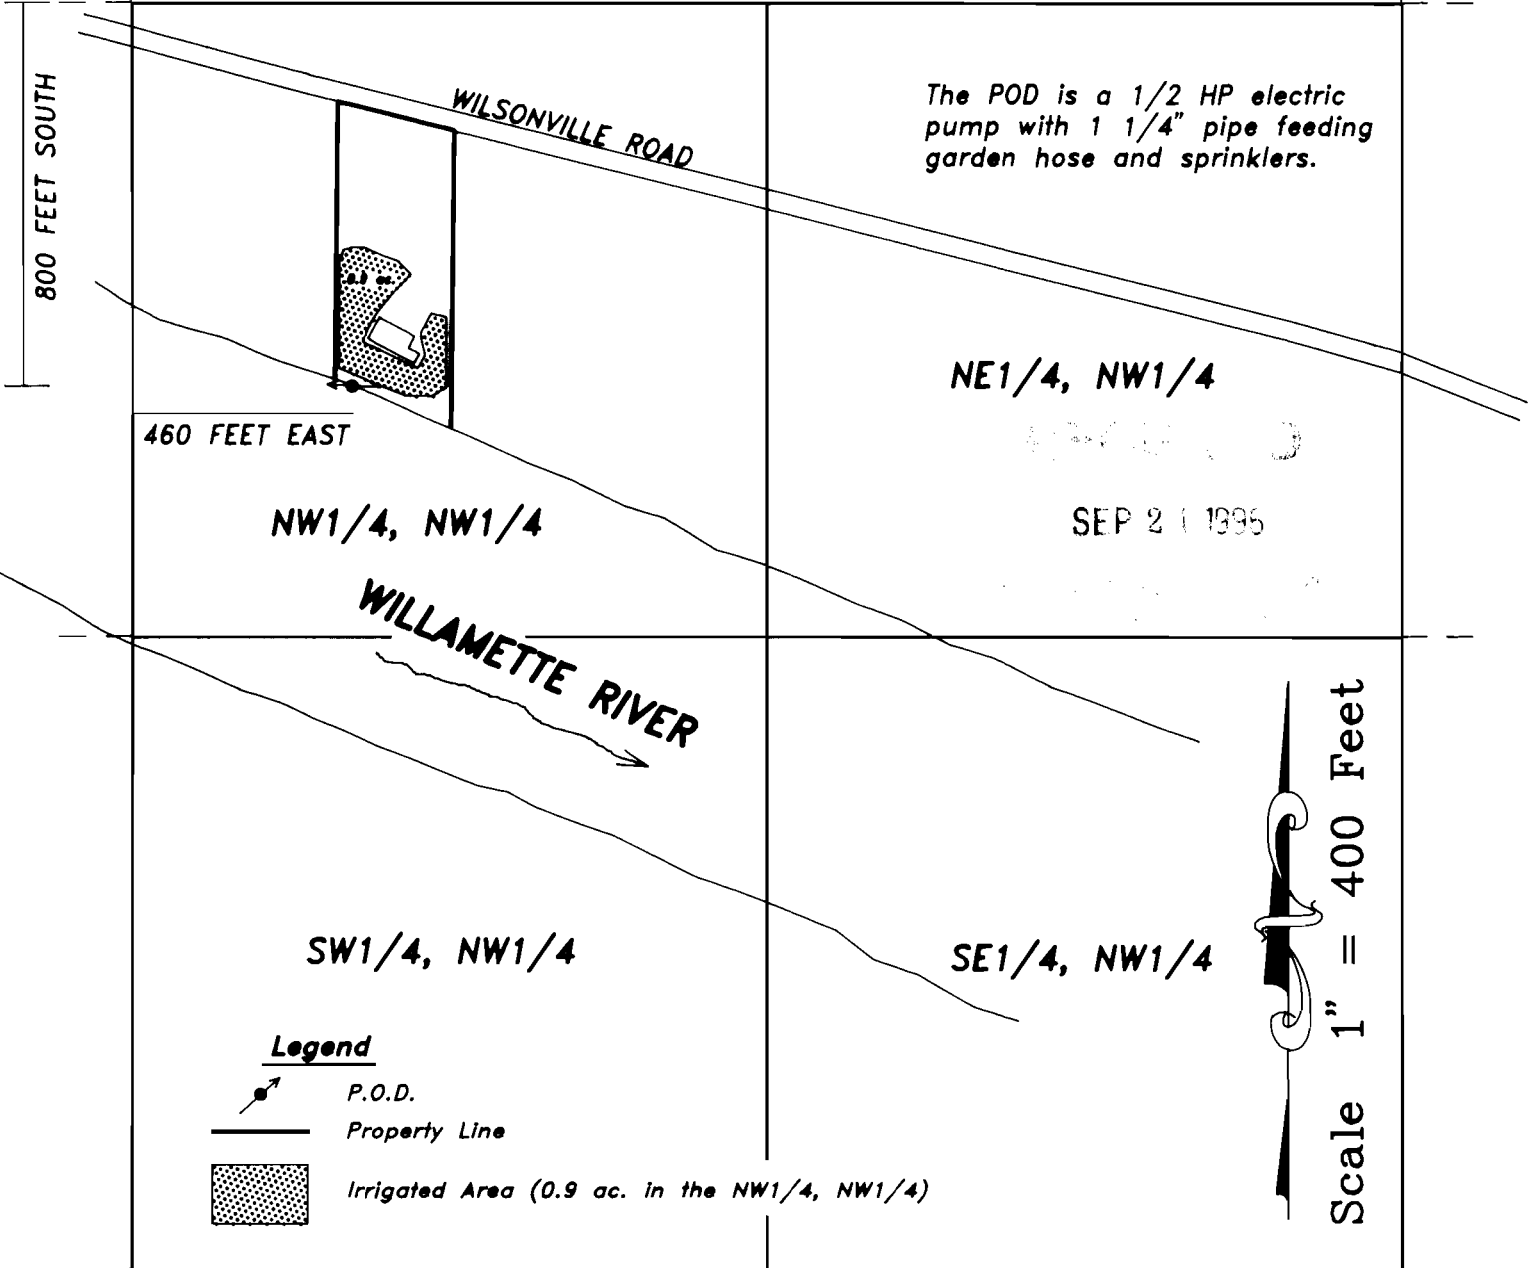

The POD is a 1/2 HP electric pump with 1 1/4" pipe feeding garden hose and sprinklers.

W1/4 Corner
 Section 1

C1/4 Corner
 Section 1

EXAMINERS DISCLAIMER STATEMENT

The preparation of this map was for the purpose of identifying the location of the Water Right only and has no intent to provide dimensions or location of property ownership lines.



FINAL PROOF SURVEY

IN THE NAME OF

Elizabeth and Andrew Rapp

Surveyed on August 7, 1996 by Anthony C. Benthin

Application #69891

Permit #50674