


TWP. 38 S. R. 5 W

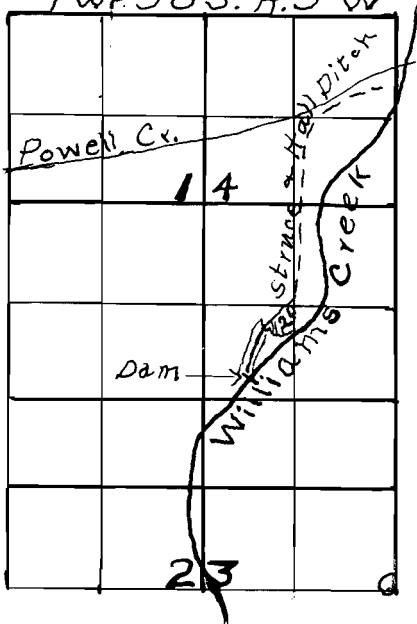

7927

5084