

COMPUTATION SHEET

SHEET ..... OF .....

MADE BY .....


CHECKED BY .....  
(Initial and date)

Subject: **WATER**

**APPLICATION FOR PERMIT SILVER  
CREEK MARSH TO APPROPRIATE SURFACE WATER**

R 13 E

T  
30 S

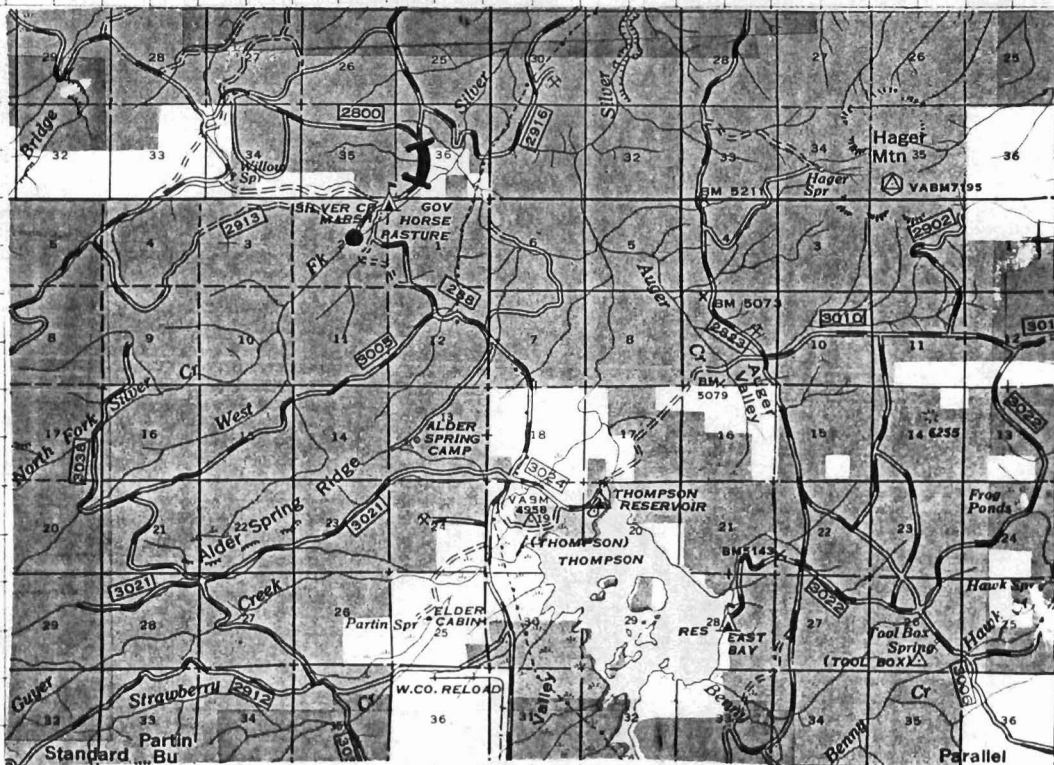

■ WATER USE

● WATER SOURCE

REGISTERED  
MAY 11 1960  
WATER RESOURCES DIV  
SILVER LAKE, OREGON

Application No. 60013  
Permit No. 50901

SECTION


50901

2  
SW  $\frac{1}{4}$  NE  $\frac{1}{4}$

TOWNSHIP 30 RANGE 13 W. M.  
SILVER CR. MARSH.  
SILVER LAKE R/D.  
FREMONT N.F.

NORTH

Scale 8" = 1 mile

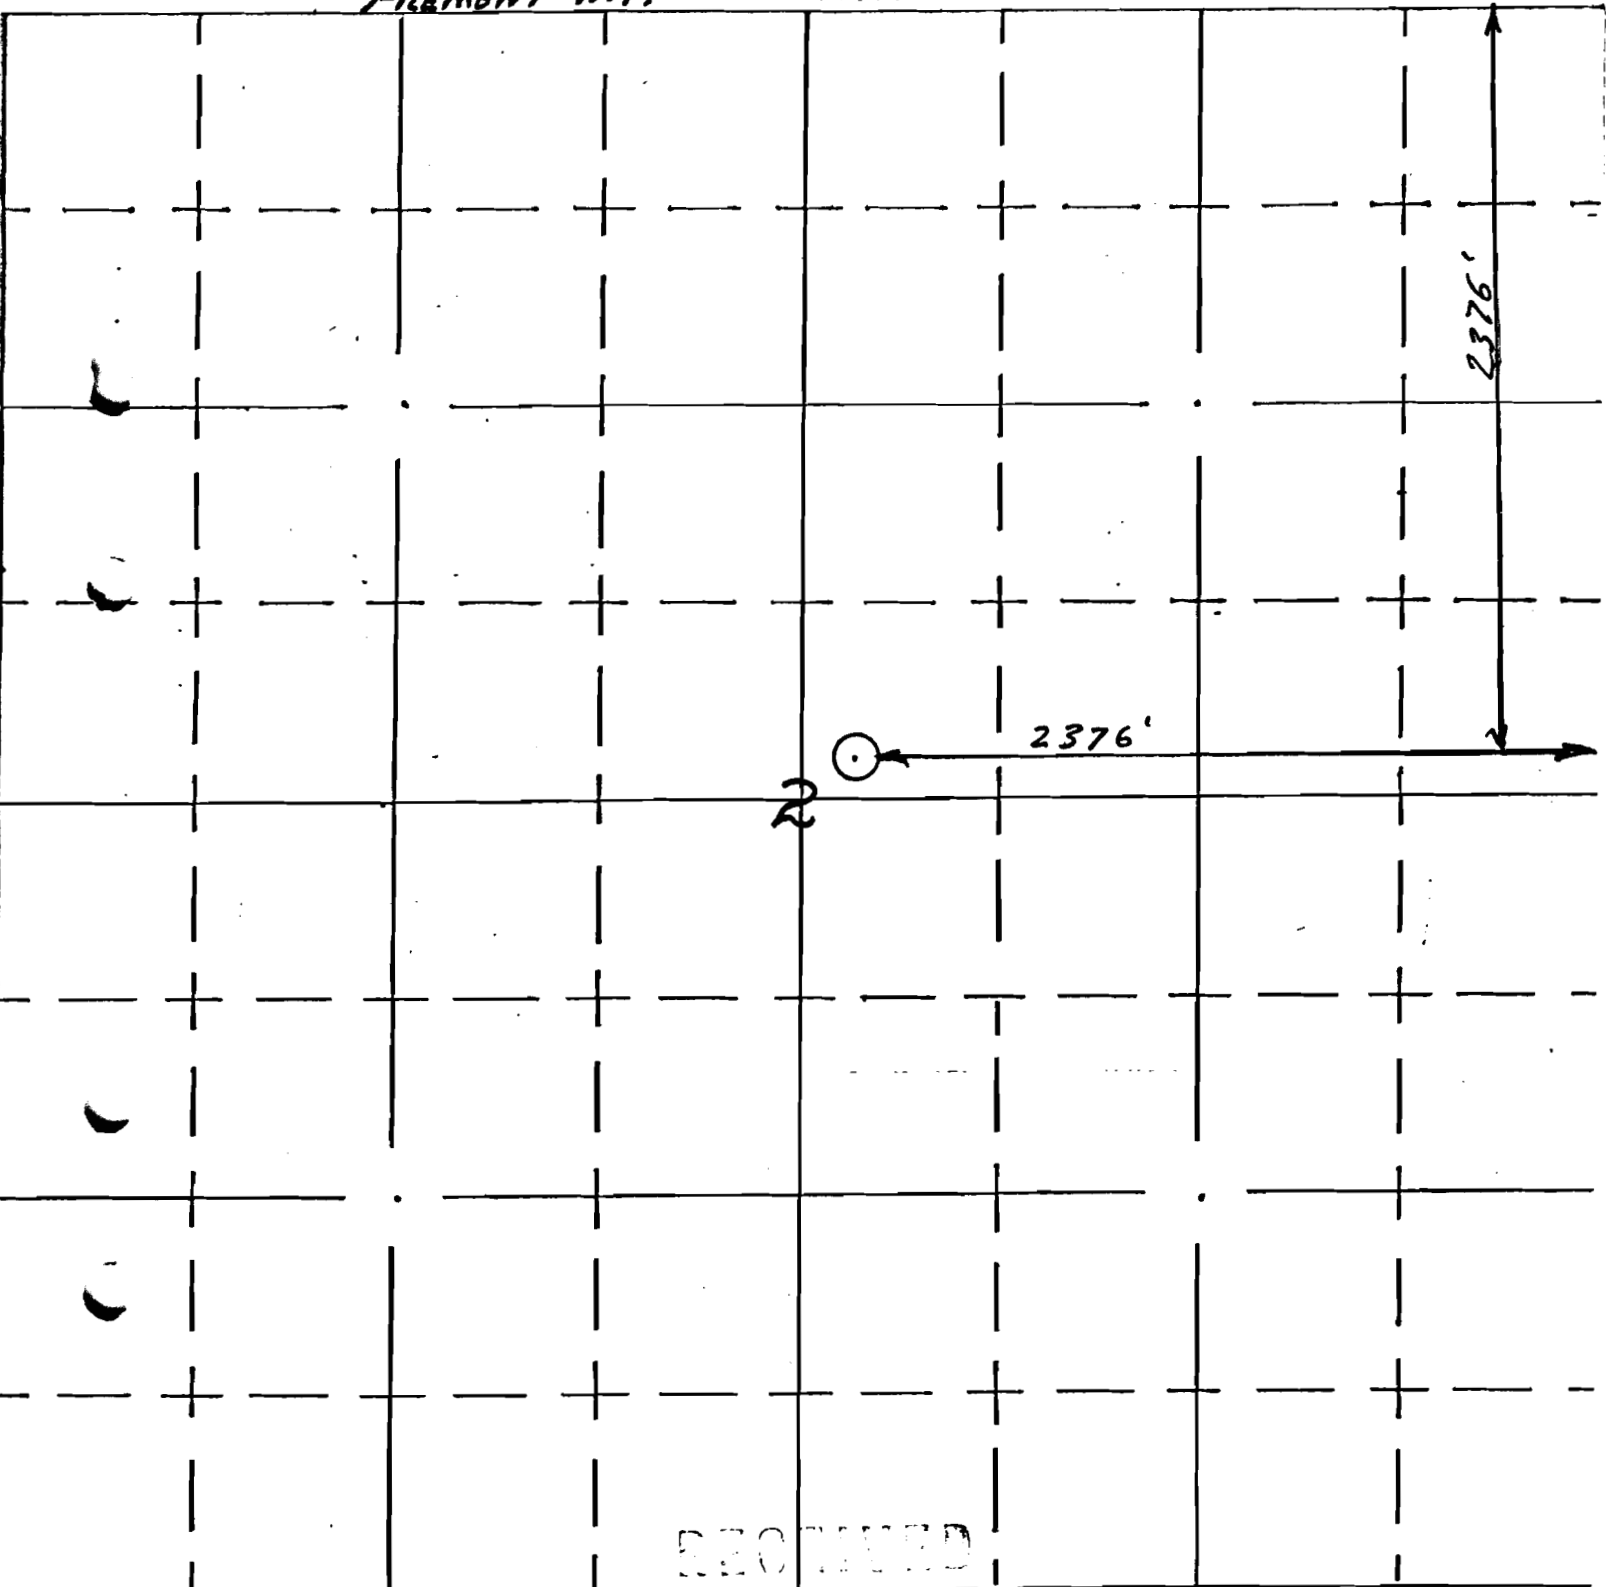

RECEIVED

ASOUTHU

WATER RESOURCES DEPT  
SALEM, OREGON

APPLICATION NO.  
PERMIT NO.

⊙ WATER SOURCE

Application No. 6003

Permit No. 50901