

FIELD MAP SHEET

66208

T. 37S R. 18E Sec. 34 Subdiv. NW 1/4 - NE 1/4 FREMONT NE

Scale 8.2 inches = 1 Mile

APPLICATION NO. _____


PERMIT NO. _____

⊙ = WATER SOURCE

Application No. 5996

Permit No. 50908

NORTH

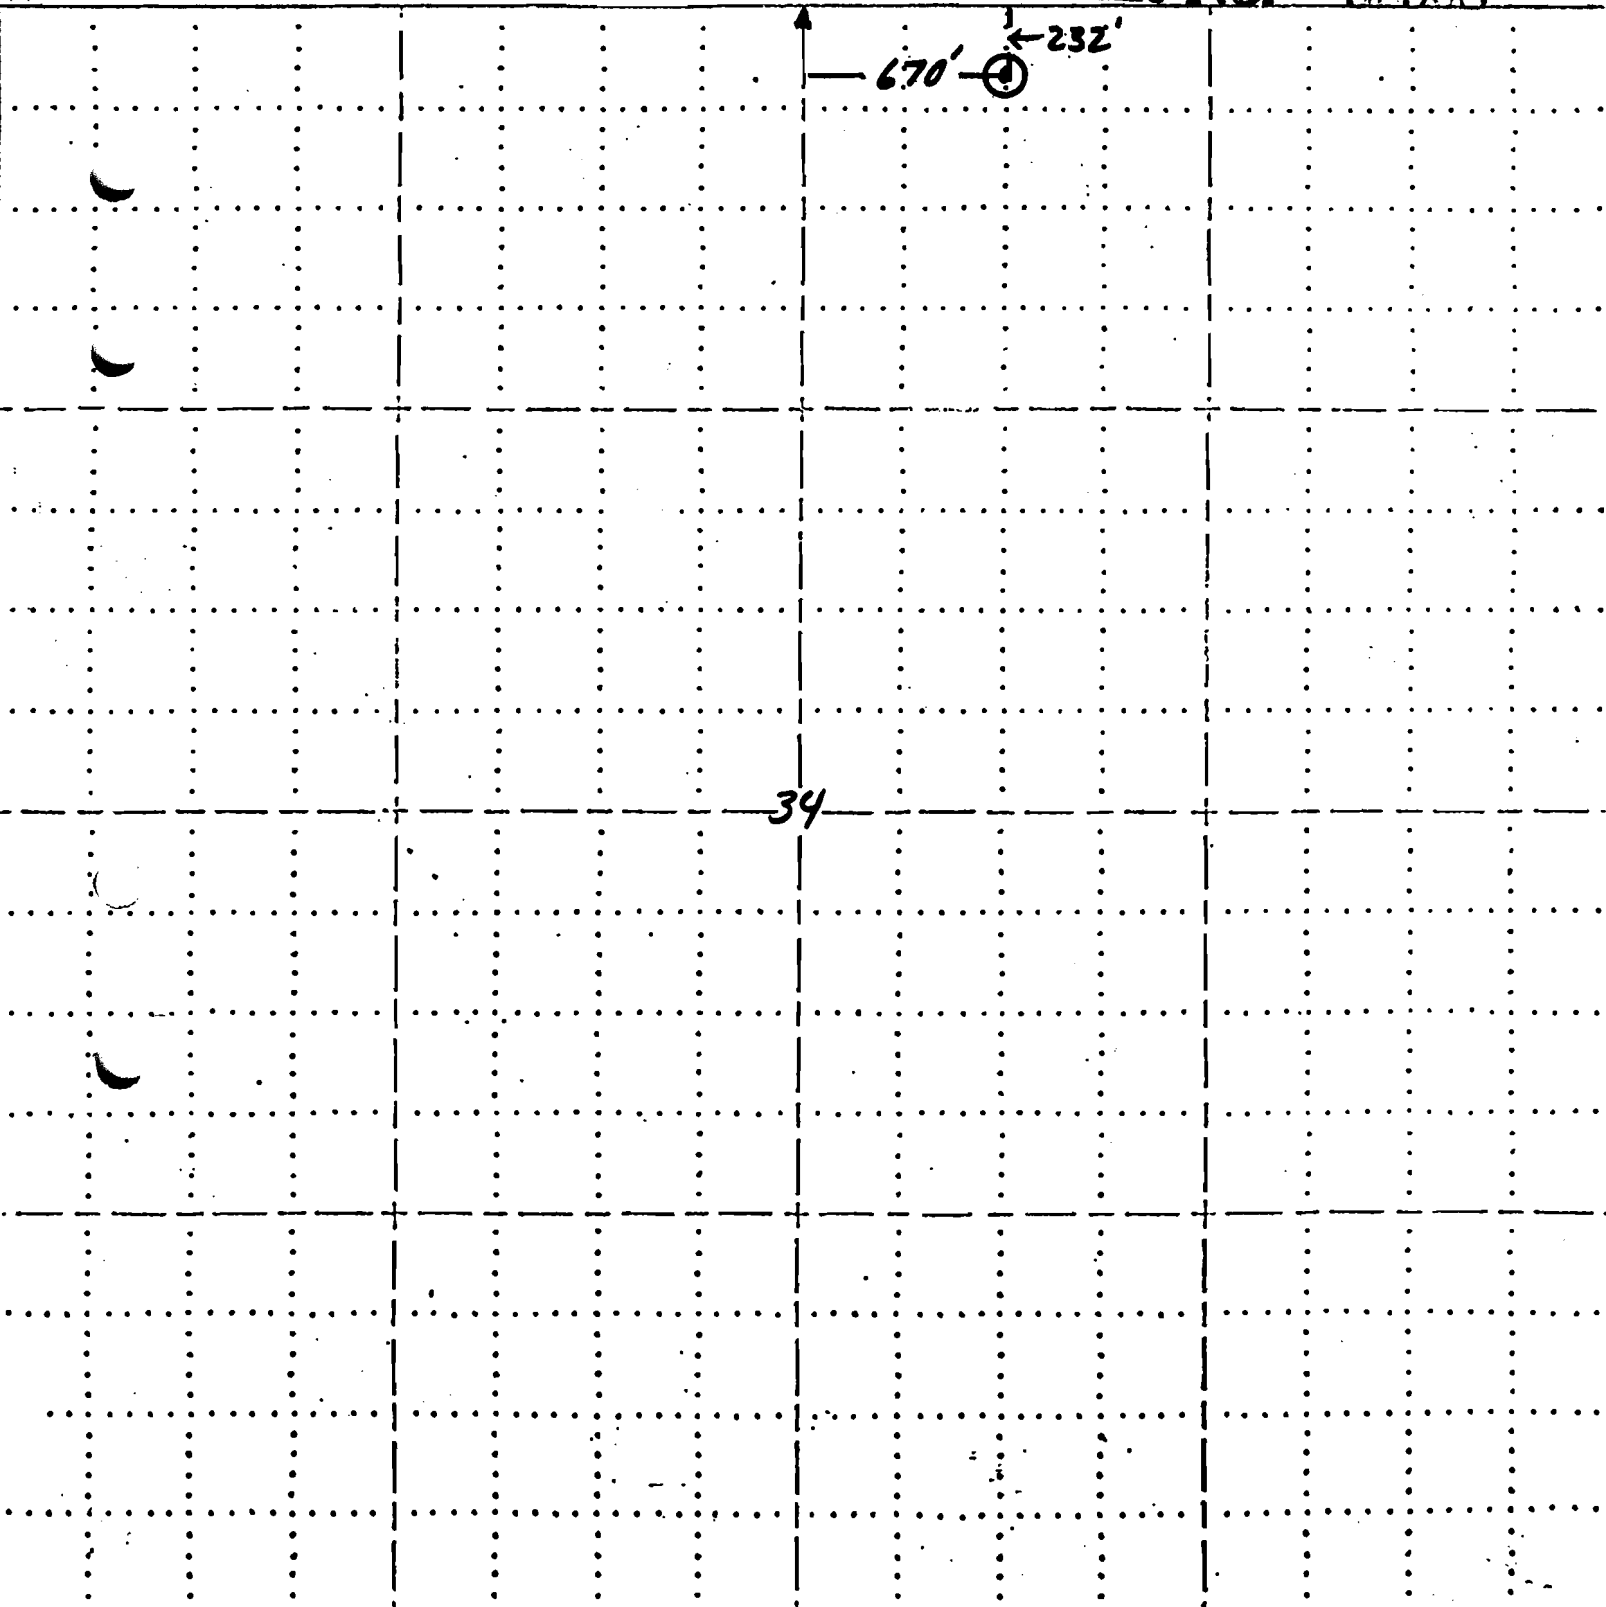


RIBE

O = WATER SOURCE
- = WATER USE



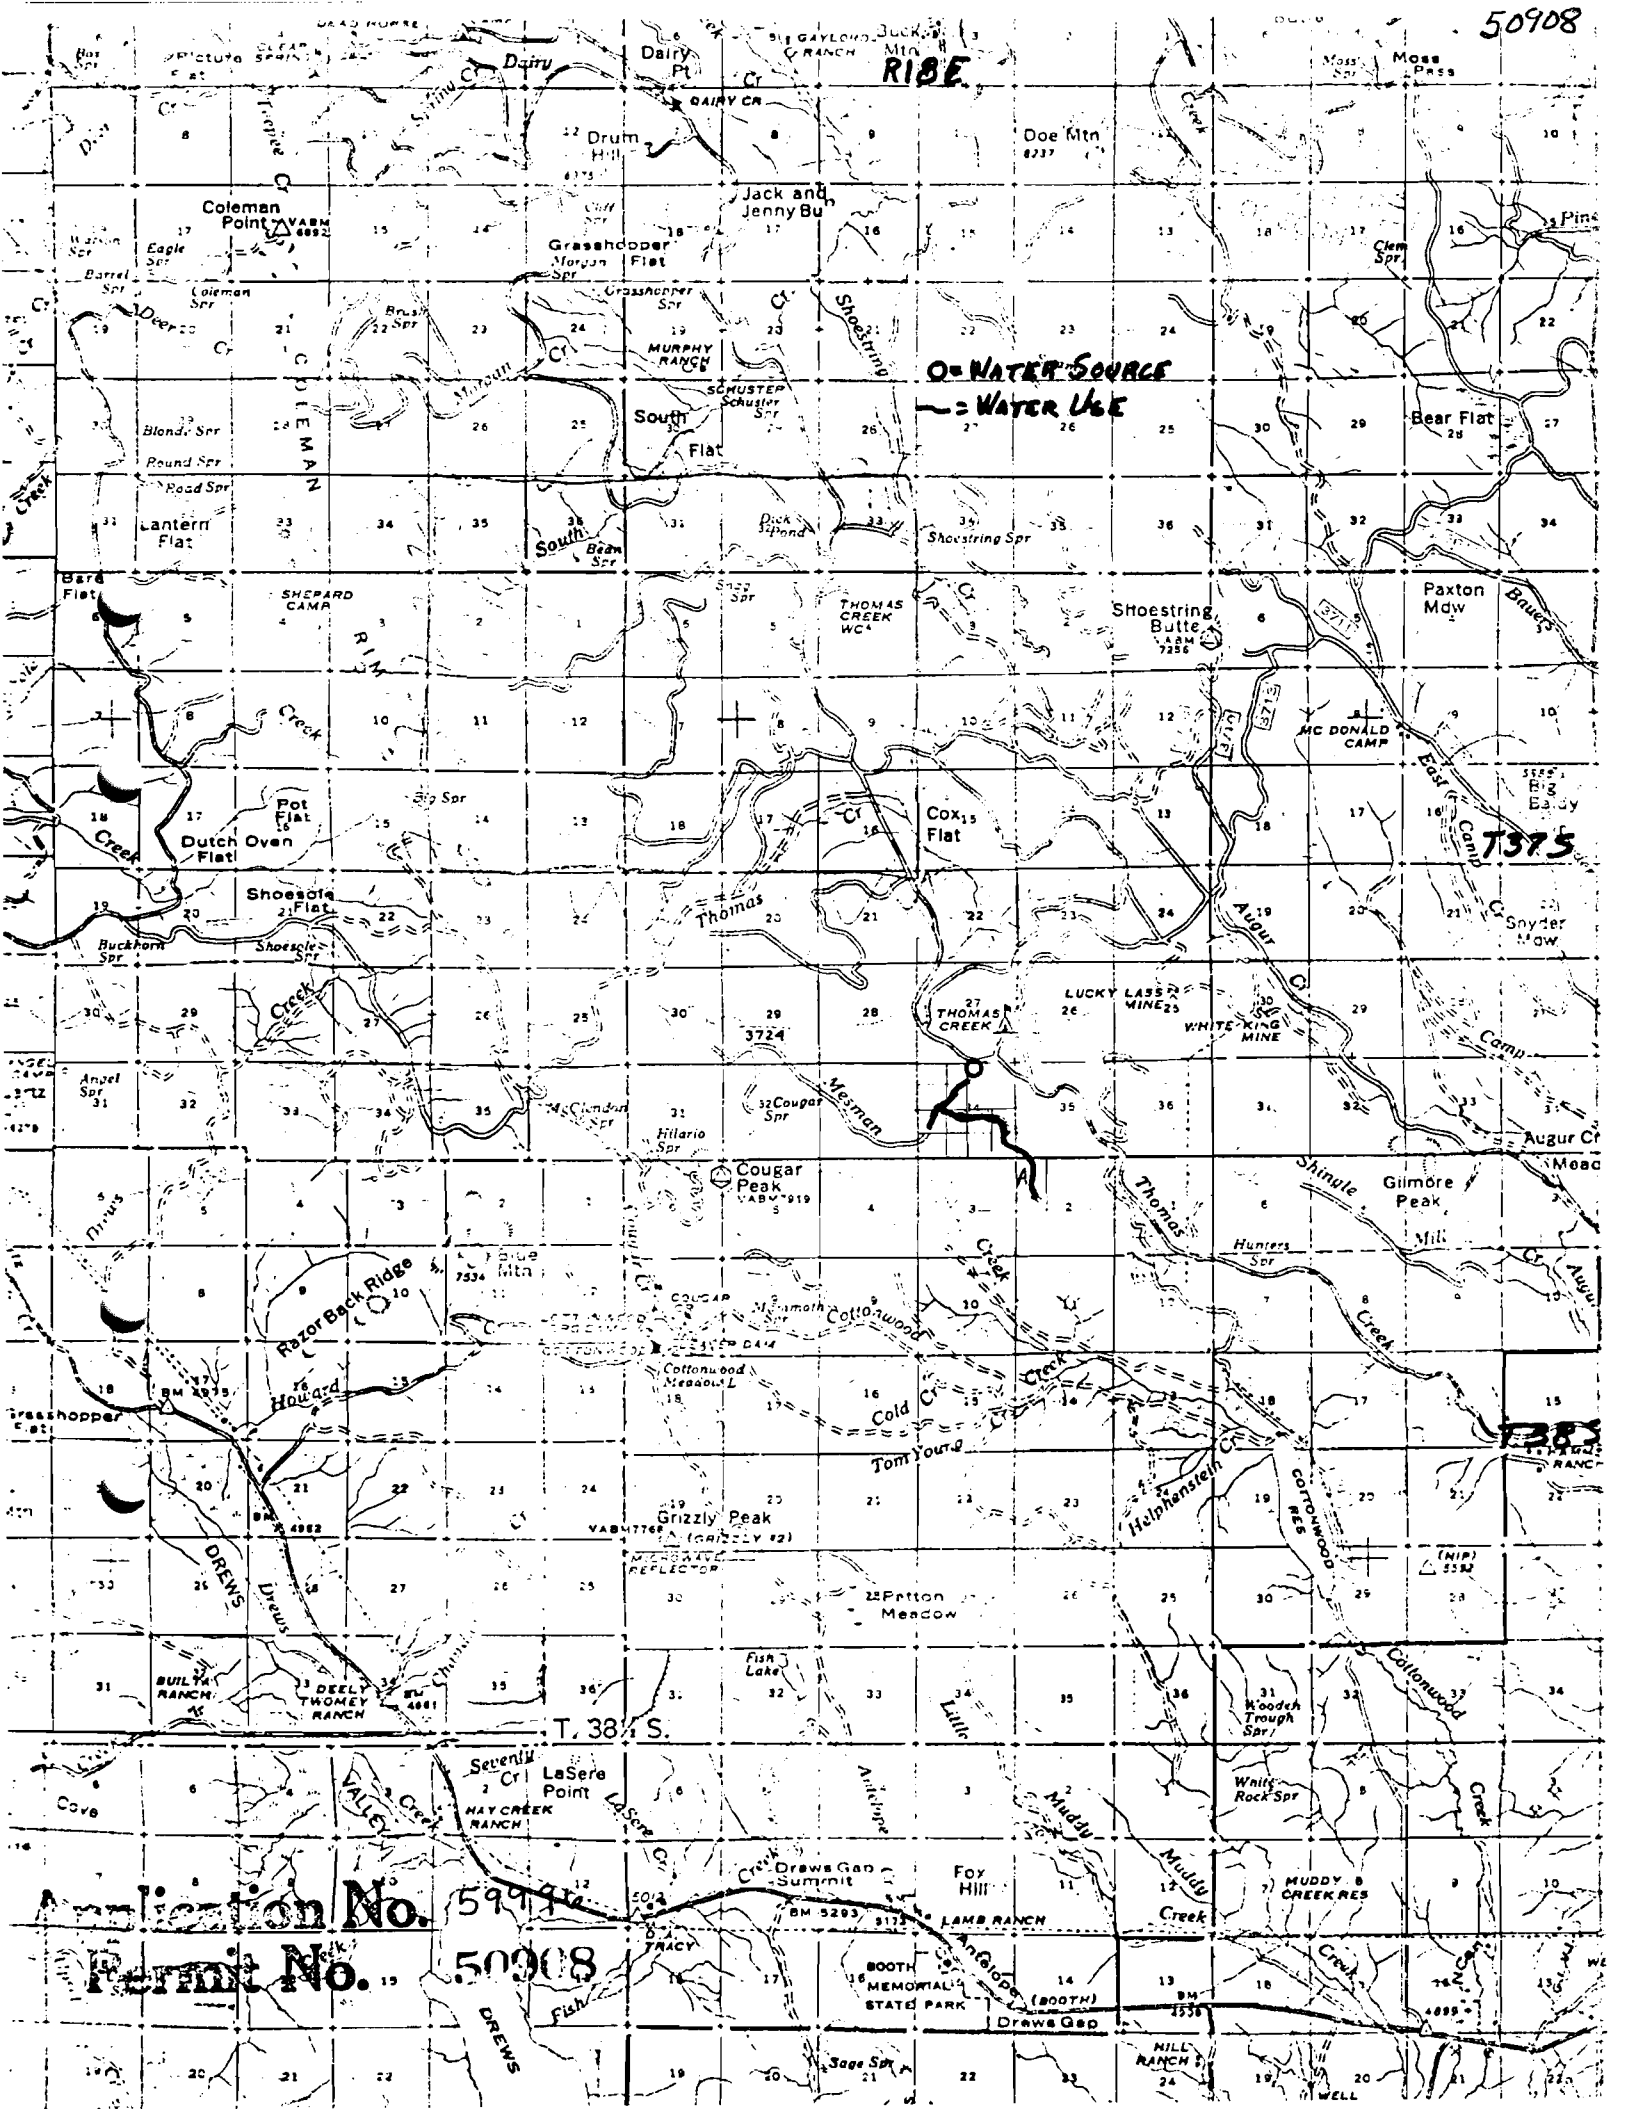

Application No. 5999
 Permit No. 50908

T. 38, S.

 Foy Hill
 LAMB RANCH

BOOTH MEMORIAL STATE PARK

HILL RANCH
 WELL