

50913
66206

FIELD MAP SHEET

APR 21 1930
WATER RESOURCES DEPT.
SALEM, OREGON

T. 39S R. 21E Sec. 3 Subdiv. NW 1/4, SE 1/4

FREMONT

APPLICATION NO. 59988

Scale 8.2 inches = 1 Mile


PERMIT NO. _____

Application No. 59988

⊙ = WATER SOURCE


Permit No. 50913

NORTH

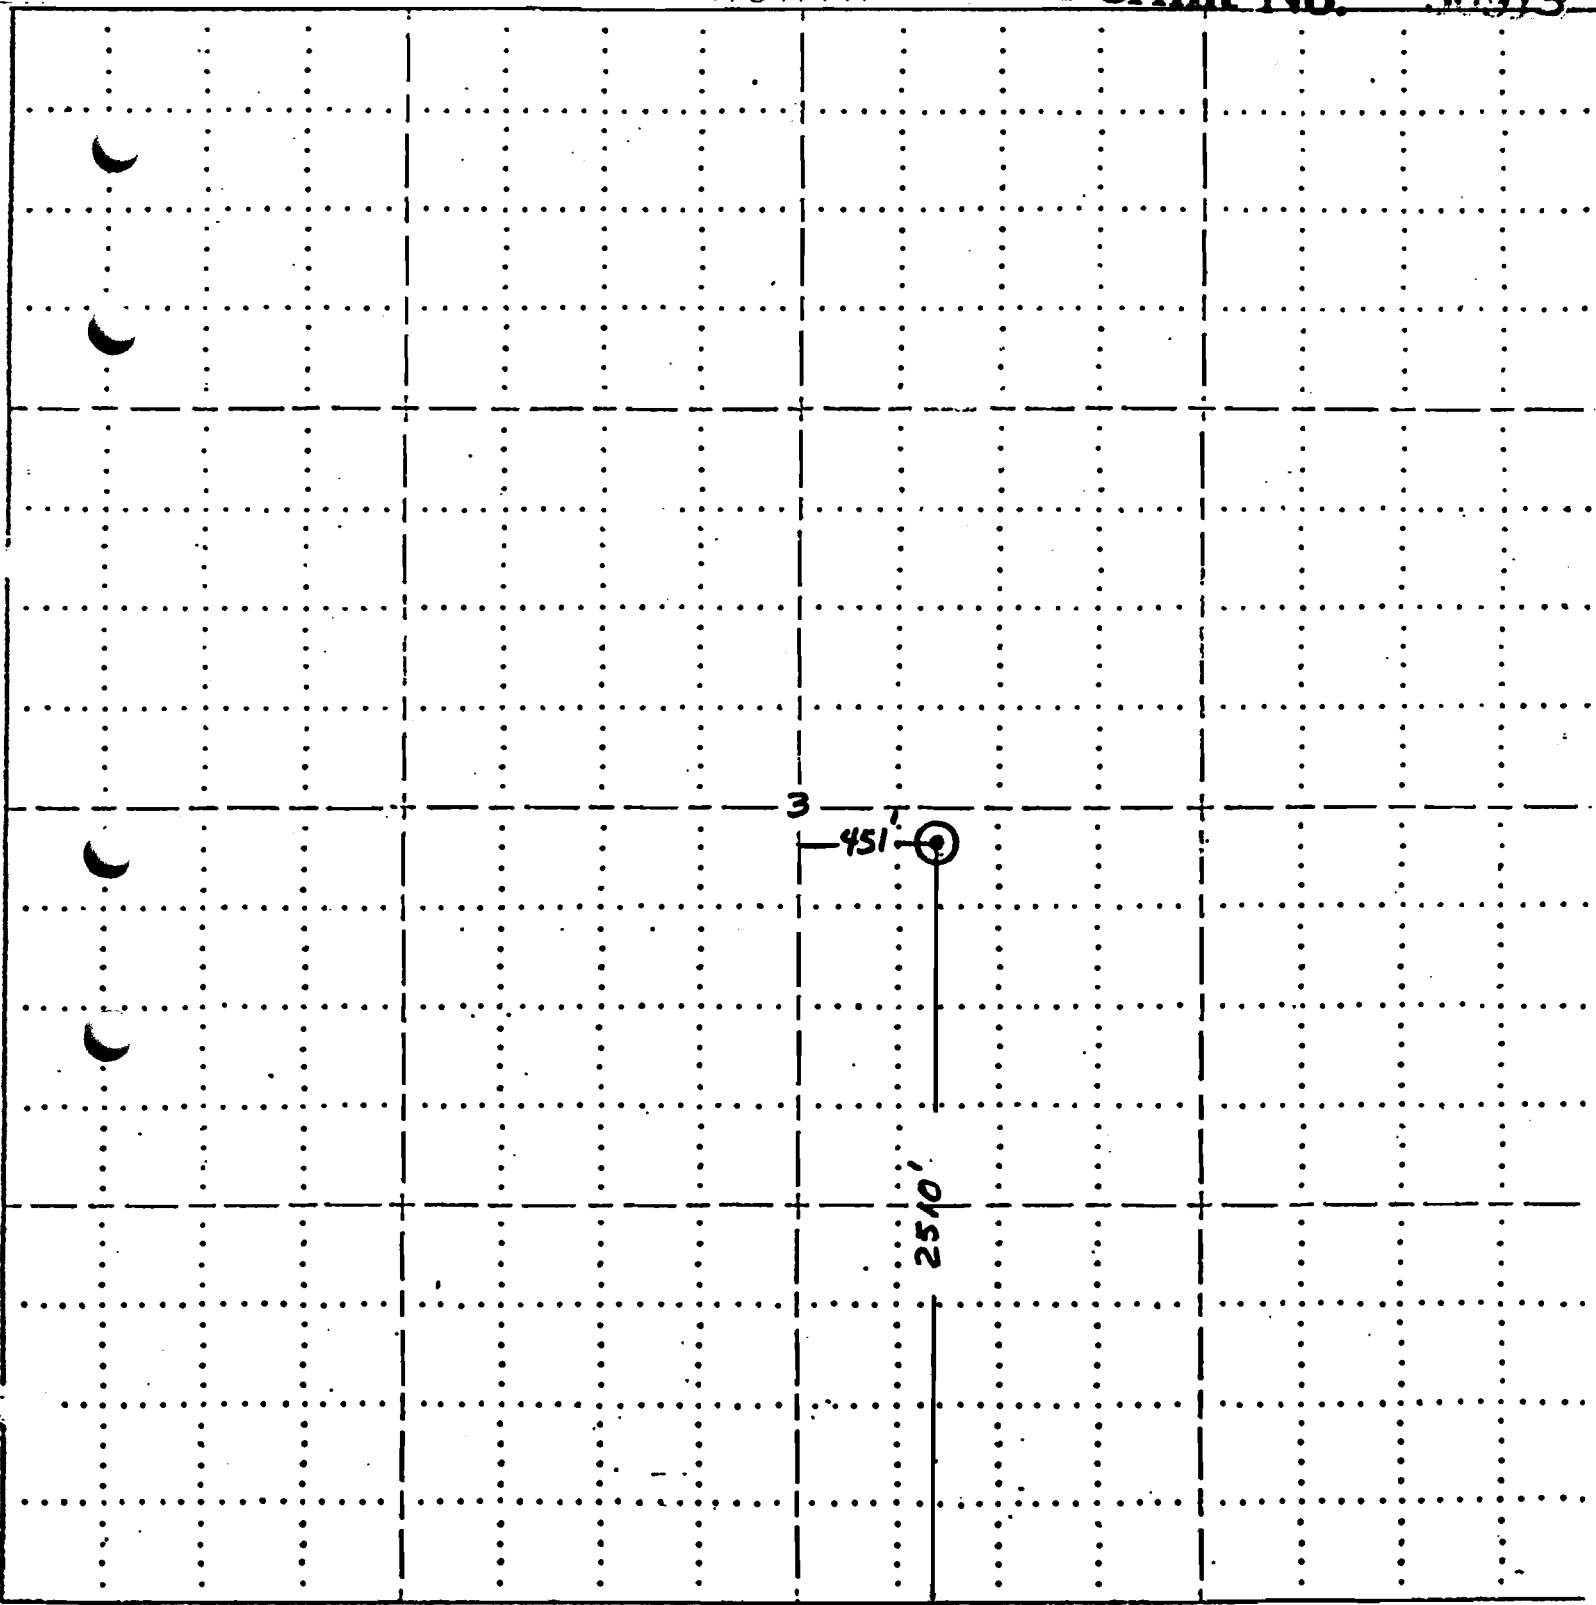

WATER USE

R. 23 E.

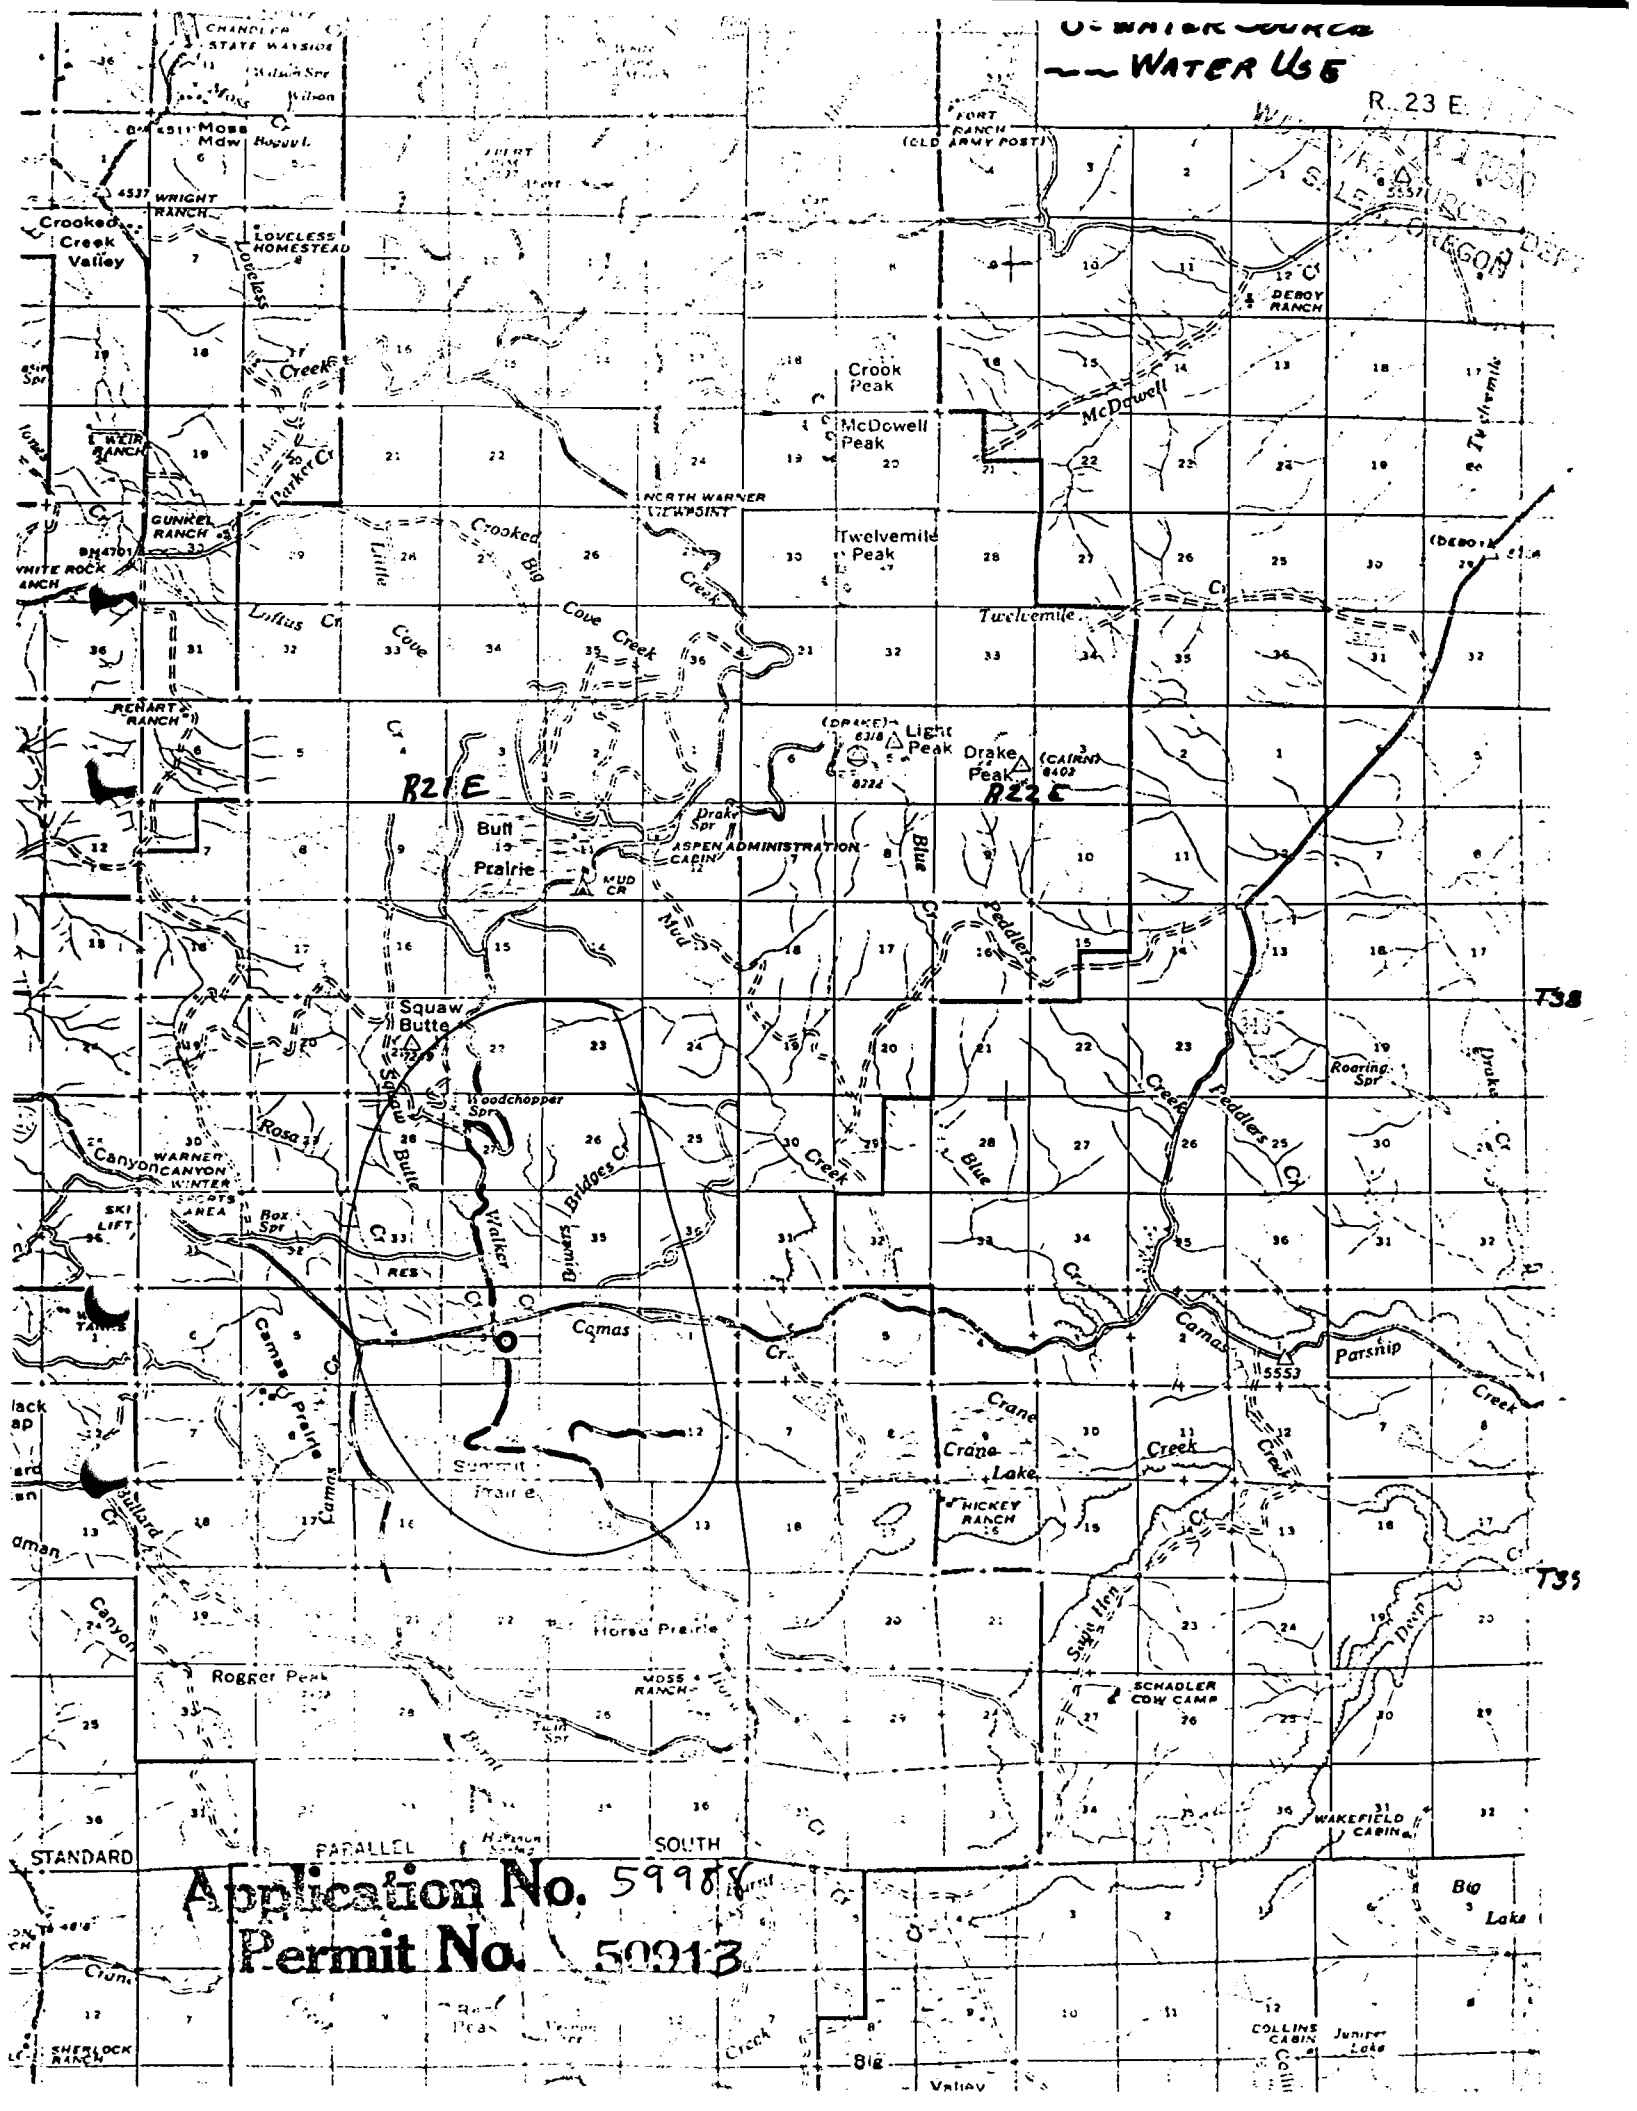

Application No. 59988
Permit No. 50913

STANDARD
PARALLEL
SOUTH

738

735

WAKEFIELD CABIN
COLLINS CABIN
Juniper Lake