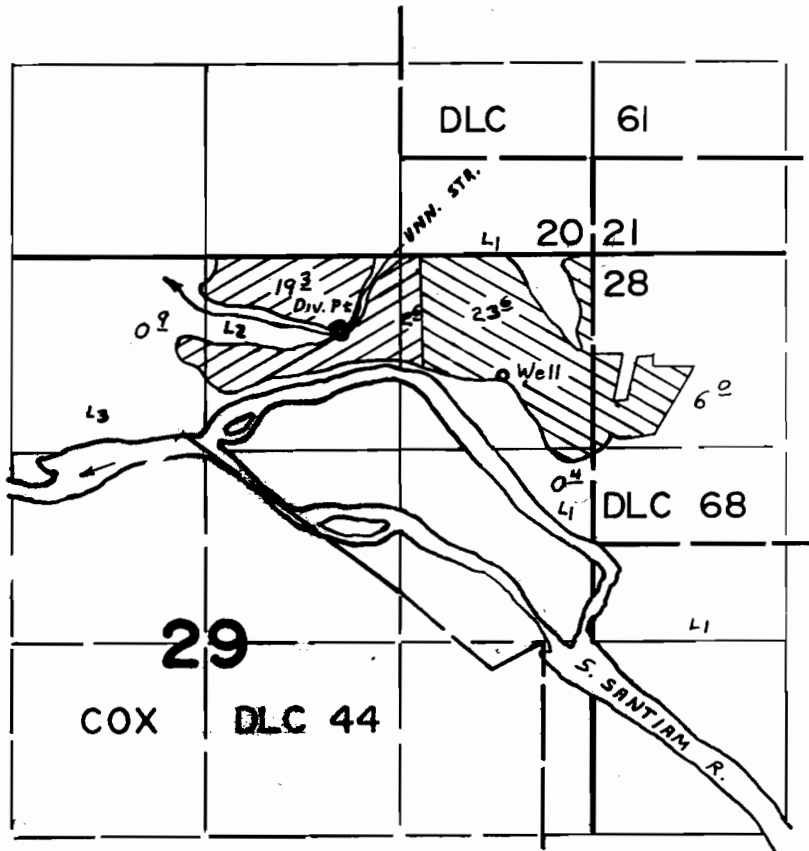


RECEIVED

DEC 06 1990

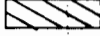

T.10S. R.2W., W.M.

WATER RESOURCES DEPT
SALEM, OREGON



Div. Pt. Loc. 520' S. of 1720' W.
Well Loc. 820' S. of 620' W.

Both From N.E. Cor. Sec. 29

	G-7476
	54648

FINAL PROOF SURVEY
UNDER

54648 41008
Application No. G-7476... Permit No. G-6960...
IN NAME OF

FRED P. JETER

Surveyed APR. 13. 1978, by S.P. APPLGATE

70974
51214