


Point of diversion is 460 ft. North and 1,500 ft. West of the SE Section Corner Section 14, T 22 S, R 10 W, W. M.

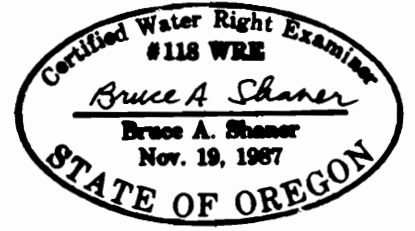

Renews June 30, 1996

**FINAL PROOF SURVEY OF A
PERMIT TO APPROPRIATE SURFACE WATER
IN THE SE 1/4 OF SECTION 14, T 22 S,
R 10 W, W. M., DOUGLAS COUNTY, OREGON
Application No. 71440
Permit No. 51252**

**For: Neil R. & Betty M. Comfort
1850 Scottsburg W. Road
Scottsburg, Oregon 97473**

**By: Shaner Engineering, Inc.
P. O. Box 1430
Roseburg, Oregon, 97470**

August 4, 1995