


T. 34 S. R. 8 W

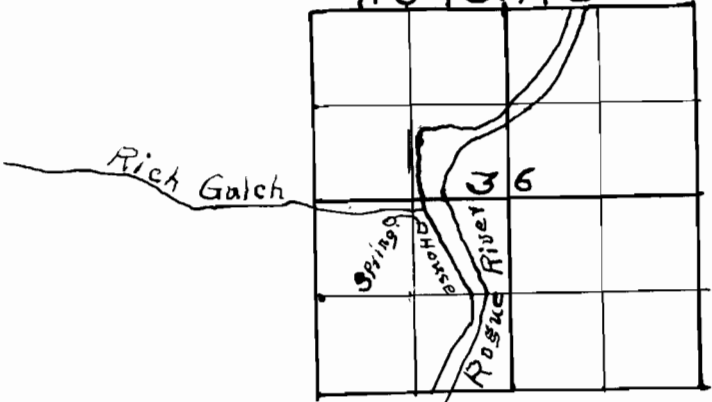

7975  
5128