


T. 8 & 9 S. R. 4 W. W.M.

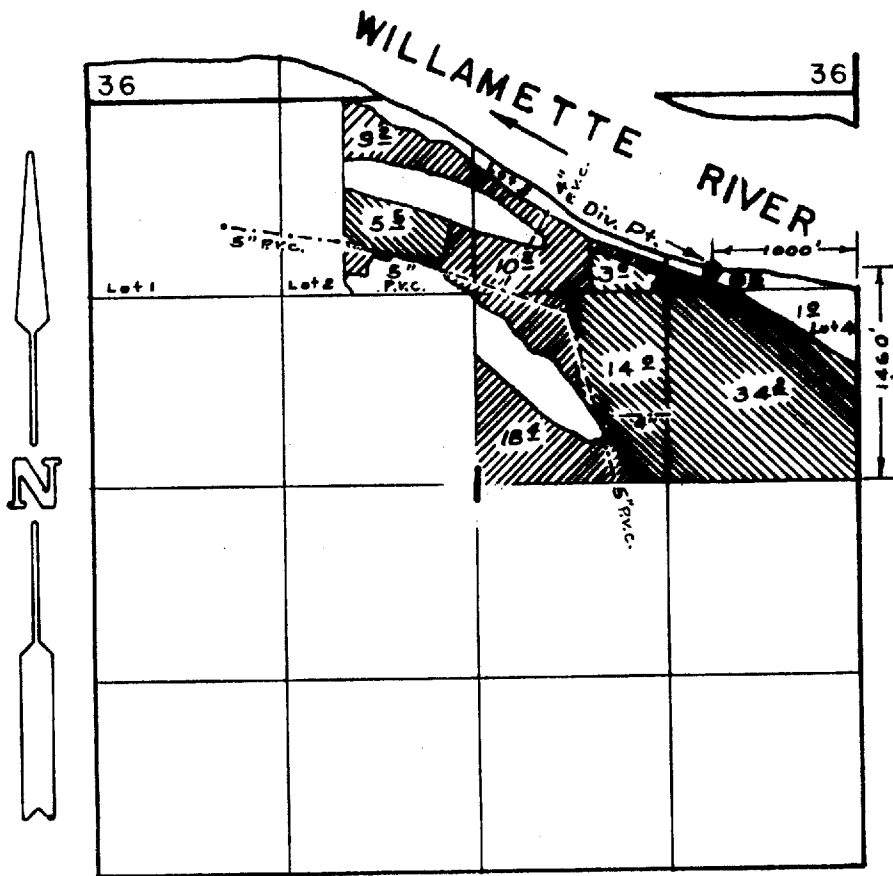

Scale 1" = 1320'



CERT. No. 15168

Final Proof Survey  
Applic. 70971 Permit 51285  
In Name of  
JOEL A. HOOVER

THE PREPARATION OF THIS MAP IS FOR THE PURPOSE OF IDENTIFYING THE LOCATION OF THE WATER RIGHT ONLY AND HAS NO INTENT TO PROVIDE DIMENSIONS OR LOCATION OF PROPERTY OWNERSHIP LINES.

