


T.13S.,R.20E.W.M.

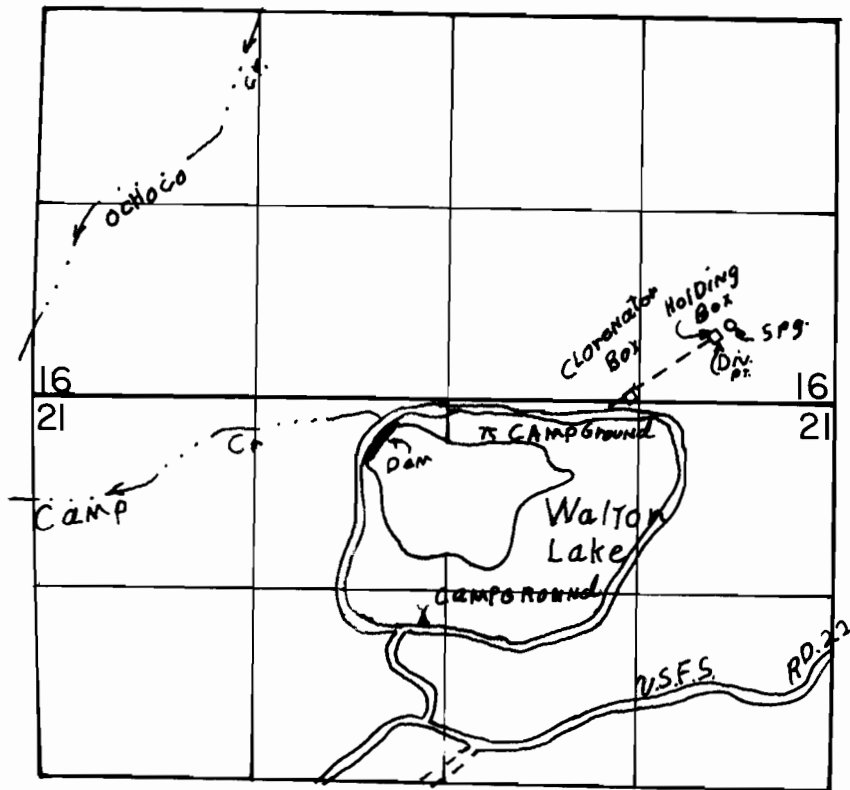

DIV. PT. LOC: 400' N & 840' W FROM SE COR. OF SEC 16.

SCALE: 1" = 1320'

### FINAL PROOF SURVEY UNDER

Application No. 66419. Permit No. 51293.....  
IN NAME OF

UNITED STATES, OCHOCHO NAT. FOREST

Surveyed JULY 19 1995., by R.M. SUTTERFIELD