


RECEIVED

OCT 17 1995

WATER RESOURCES DEPT  
SALEM, OREGON

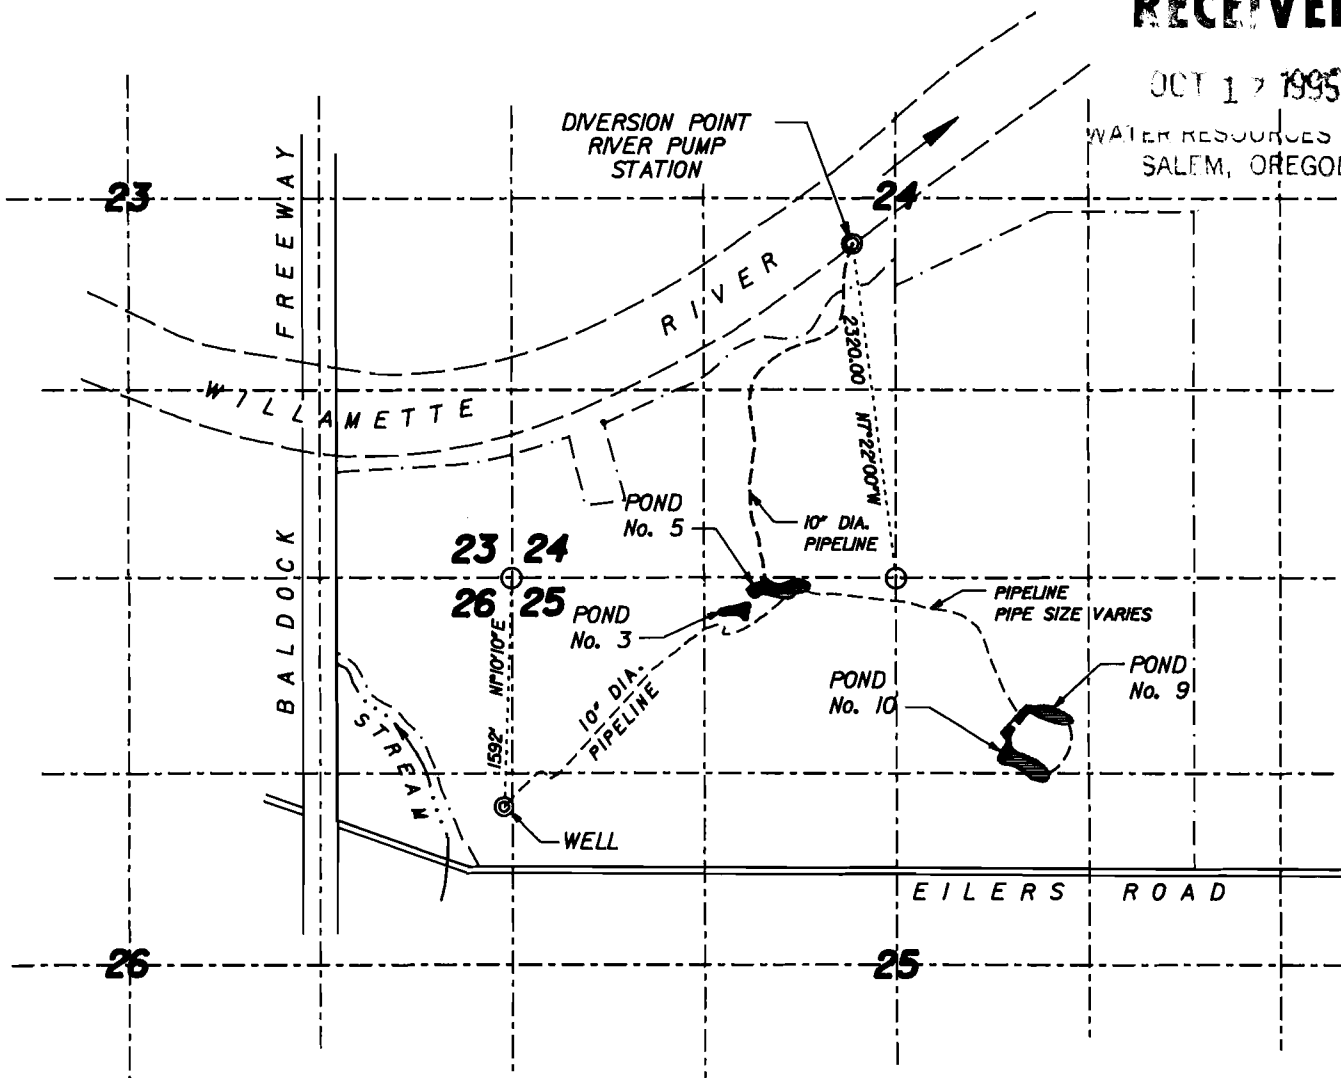

This drawing is an exhibit for a Final Proof Survey. It is not a Land Survey. Property lines and/or other lines of occupation shown hereon are not represented by the undersigned to meet accuracy standards of Land Surveys.




SCALE: 4" = 1 MILE

**SECTIONS 24 & 25, T.3S., R.1W., W.M.  
CLACKAMAS COUNTY, OREGON**

Certified Water Rights Examiner  
#056  
*J. H. Greenman*  
J. H. Greenman  
Nov. 19, 1987  
STATE OF OREGON  
95/10/13

Application No. **70420**

Permit No. **51471**

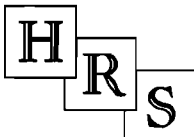

**HANER, ROSS &  
SPORSEEN, INC.**  
15 S.E. 82ND DRIVE  
GLADSTONE, OREGON 97027

**FINAL PROOF SURVEY**  
IN NAME OF  
CHARBONNEAU GOLF CLUB, INC.

612G

9/19/95 efr a:\uwrh\dgm\612gpb