
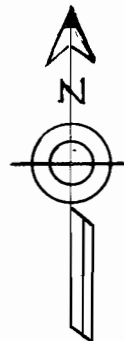


WATER OF STATE OWNERSHIP  
...  
JUL 21 1988  
...

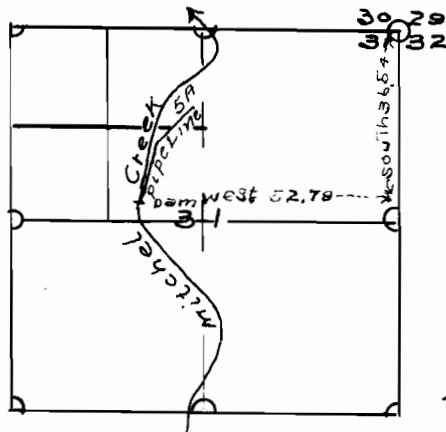

SCALE  
40.00 CHINS TO 1 INCH

79744  
5748

MITCHEL CREEK PIPE LINE  
LOCATED

IN

SEC. 31 T. 30 S. R. 5 W.