


T. 4 S., R. 4 E., W. M.

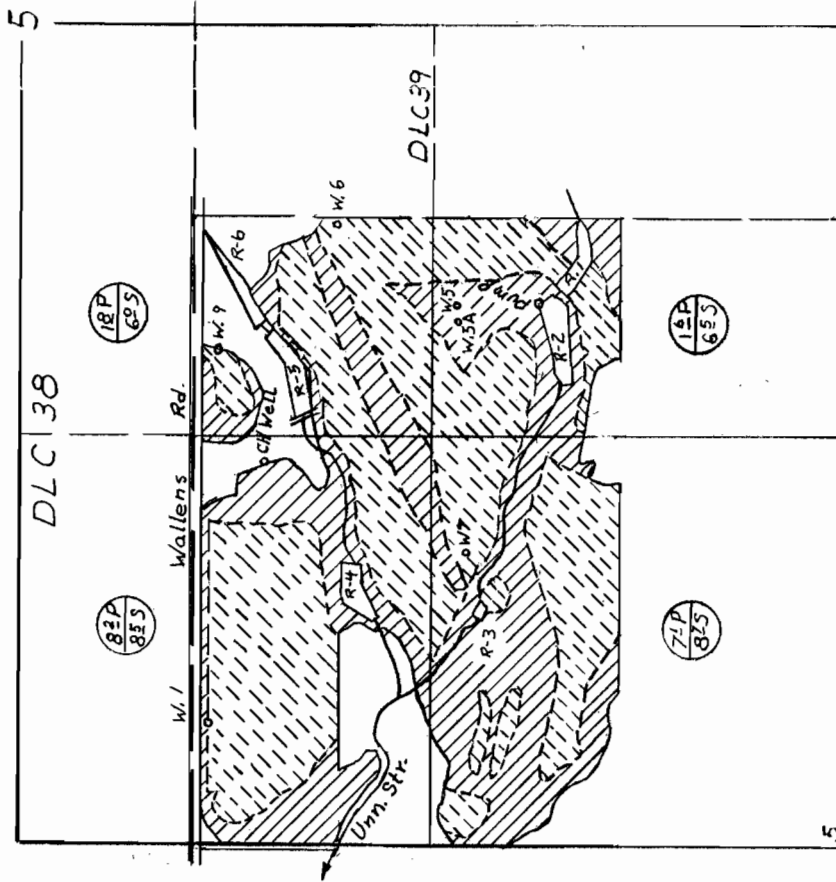

Water Right Map For
Springwater Golf Course




Scale
1" = 400'

All div. pts located from N.W. cor. DLC 39

RESERVATION	WELLS
R-1 1190' S 230' W	W.1 100' S 1550' W
R-2 1180' S 530' W	W.5 840' S 280' W
R-3 920' S 1380' W	W.5A 850' S 330' W
R-4 580' S 1390' W	W.6 460' S 30' W
R-5 350' S 640' W	W.7 880' S 1070' W
R-6 220' S 350' W	C.H. 230' S 780' W
	W.9 80' S 430' W

THIS MAP WAS PREPARED FOR THE PURPOSE OF IDENTIFYING THE LOCATION OF A WATER RIGHT ONLY AND IS NOT INTENDED TO PROVIDE LEGAL DIMENSIONS OR LOCATION OF PROPERTY OWNERSHIP LINES.

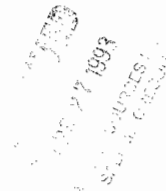

Application No. R-73359
Permit No. R1508