


T.5S., R.3W., W.M.
YAMHILL COUNTY

RECEIVED

SEP 15 1992

WATER RESOURCES DEPT.
SALEM, OREGON

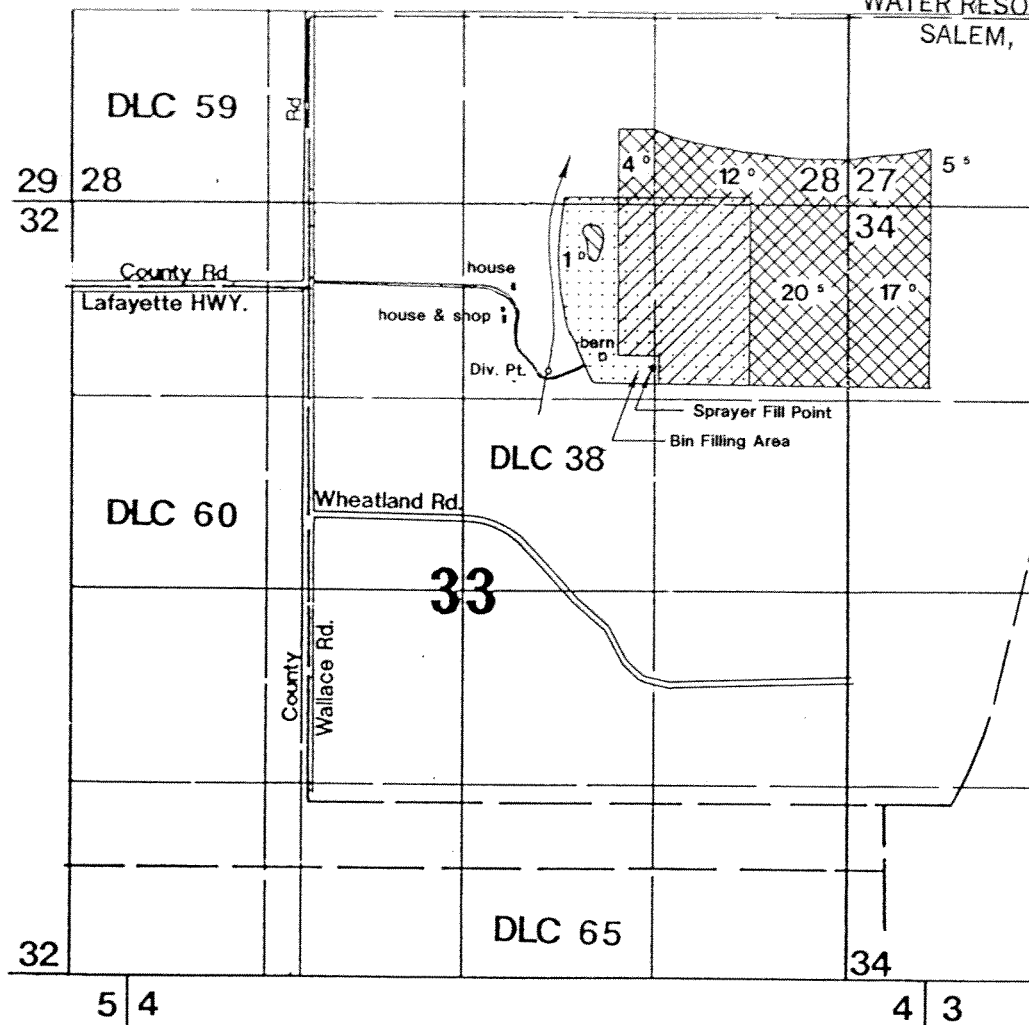

Div. Pt. of Pmt. No. 17090 described as "NW 1/4, NE 1/4, as projected in D. Matheny DLC 38, Sec. 33, T 5 S, R 3 W, WM"

Div. Pt. of Pmt No. 17090 to be consolidated w/ Div. Pt. shown for this Application being 560 ft. South & 1660 ft. East of the NE Corner of the Adam Matheny DLC No. 60.



IRRIGATION ONLY



IRRIGATION & SPRAY



SPRAY ONLY



IRRIGATION PERMIT NO. 17090

Application No. 71485 Permit No. 51600


APPLICATION TO APPROPRIATE SURFACE WATER

Roy E. Smith
Ethel M. Beaty

SEPTEMBER 8, 1992

SCALE 1" = 1320'

NOTE: This map is for the purpose of identifying the location of water rights and has no intent to dimension or locate property ownership lines.

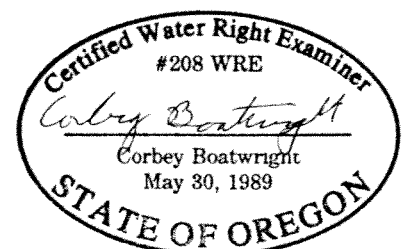


T.5S., R.3W., W.M.
YAMHILL COUNTY

RECEIVED

SEP 15 1992

WATER RESOURCES DEPT.
SALEM, OREGON

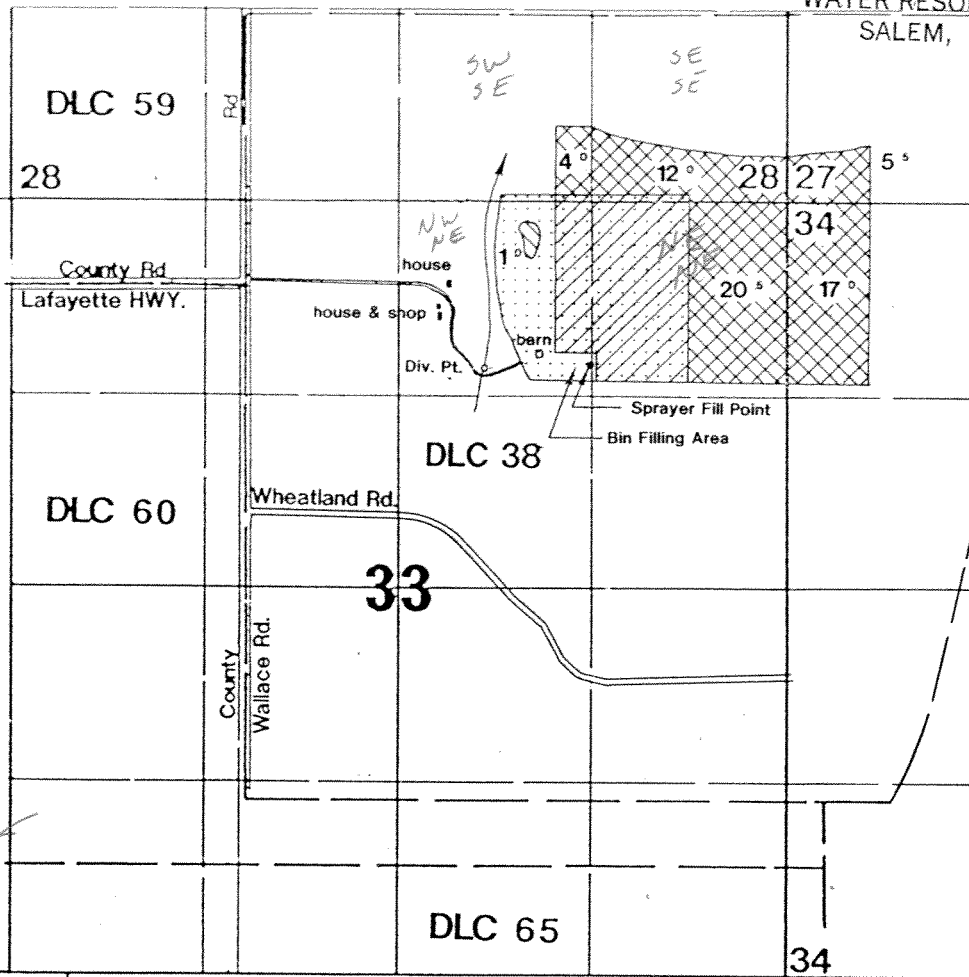

33
NE NE 1/4 21676
30 6256?
NW NE 1/4 21676
02 6256?
28
SE SE 0
SW SE 05 6366
60 65034
34
NW NW 5/8 23021
3 6 GR 119
12 6256?
15 37044
16 62681
15 612437
16 73063 supp TR being lost

Div. Pt. of Pmt. No. 17090 described as "NW 1/4, NE 1/4, as projected in D. Matheny DLC 38, Sec. 33, T 5 S, R 3 W, WM"

Div. Pt. of Pmt No. 17090 to be consolidated w/ Div. Pt. shown for this Application being 560 ft. South & 1660 ft. East of the NE Corner of the Adam Matheny DLC No. 60.

needs transfer

- IRRIGATION ONLY
- IRRIGATION & SPRAY
- SPRAY ONLY
- IRRIGATION PERMIT NO. 17090

APPLICATION TO APPROPRIATE SURFACE WATER


Application No. 71485 Permit No. _____

Roy E. Smith
Ethel M. Beaty

SEPTEMBER 8, 1992

SCALE 1" = 1320'

NOTE: This map is for the purpose of identifying the location of water rights and has no intent to dimension or locate property ownership lines.

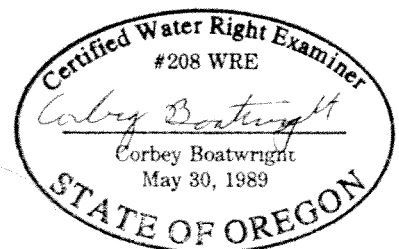

T.5S., R.3W., W.M.
YAMHILL COUNTY

RECEIVED


SEP 15 1992

WATER RESOURCES DEPT.
SALEM, OREGON

THE AG USE IS
NOT LIMITED TO
THE ACREAGES
LISTED ON PERMIT.
THE ACREAGES ON
PERMIT REFER
TO IRRIGATION.
THE PERMIT SHOULD
HAVE SAID "AG
USE" IN THE
1/4 1/4 LISTING
TO BE MORE
CLEAR.

RJK PER
DISCUSSIONS w/

JAKE & LARRY MAHN

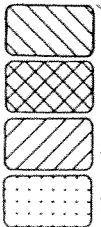

IRRIGATION ONLY

IRRIGATION & SPRAY

SPRAY ONLY

IRRIGATION PERMIT NO. 17090

Application No. 71485


Permit No. 51600

APPLICATION TO APPROPRIATE SURFACE WATER

Roy E. Smith
Ethel M. Beaty

SEPTEMBER 8, 1992
SCALE 1" = 1320'

NOTE: This map is for the purpose of
identifying the location of water rights
and has no intent to dimension or locate
property ownership lines.

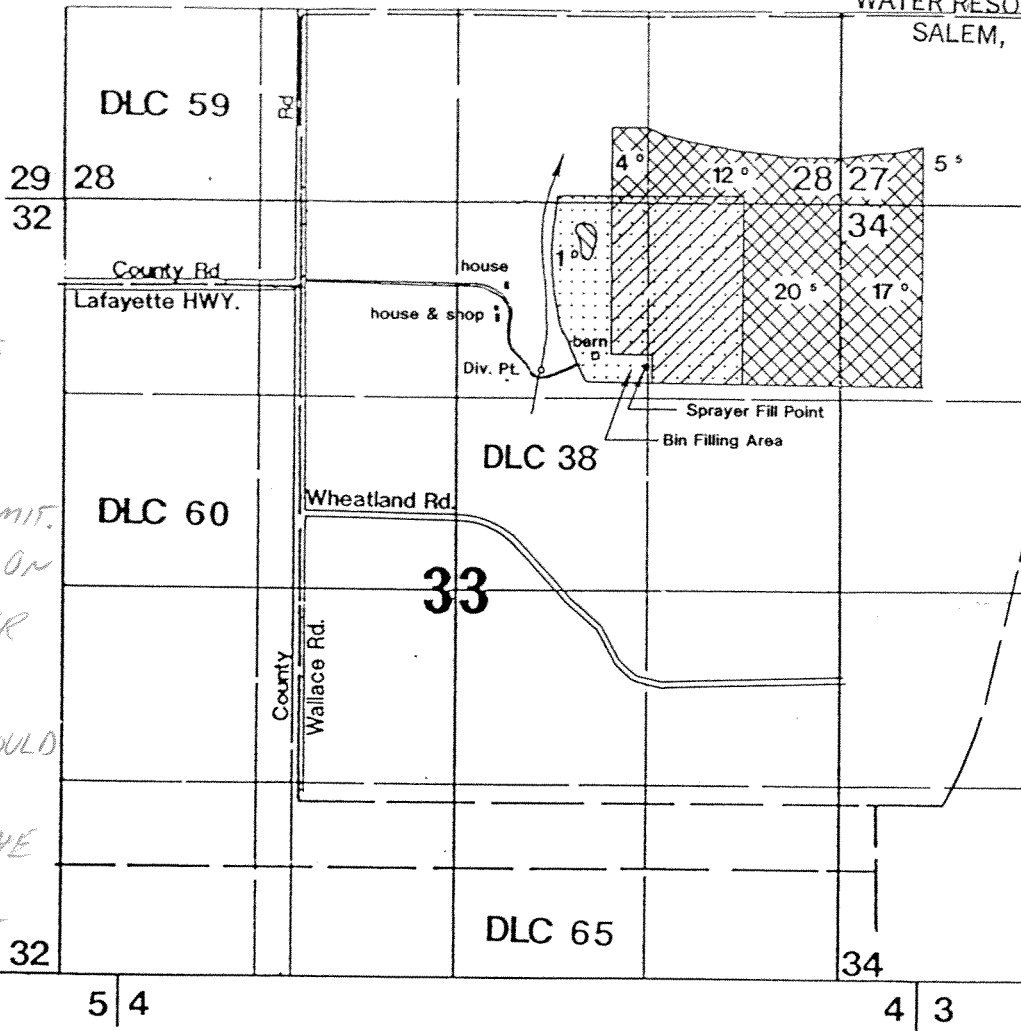

Div. Pt. of Pmt. No. 17090 described as "NW 1/4, NE 1/4, as
projected in D. Matheny DLC 38, Sec. 33, T 5 S, R 3 W, WM"

Div. Pt. of Pmt No. 17090 to be consolidated w/ Div. Pt. shown for this Application
being 560 ft. South & 1660 ft. East of the NE Corner of the Adam Matheny DLC No. 60.

