


RECEIVED

AUG 25 1994

WATER RIGHT
SALIM, OREGON

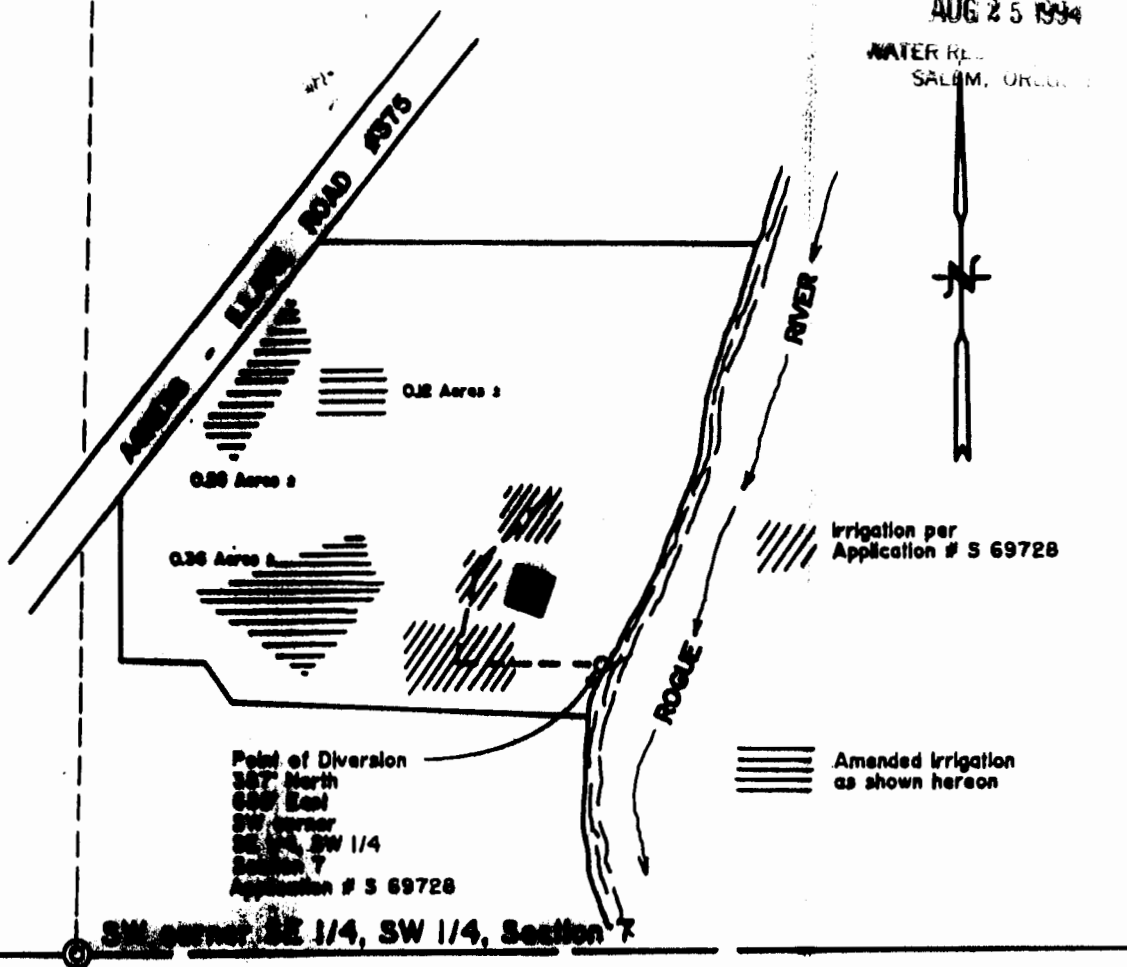

The preparation of this map was for the purpose of identifying the location of the proposed water right and has no intent to provide dimensions or location of property lines.

REVISED WATER FILING APPLICATION 69728 for WILLIAM WEBSTER and THOMAS LUCKY

PERMIT 51617

Located in the SE 1/4, SW 1/4,
Section 7, T 35 S, R 11 W, W.M.,
Curry County, Oregon
Scale 1" = 200' August, 1994



William Webster
P.O. Box 7803
Stockton, Calif. 95207

Thomas Lucky
P.O. Box 35
Agness, Oregon 97406

H.J. Neuhaus - Land Surveying
P.O. Box 260
Wendover, Oregon 97491
(503) 747-2623
C.W.R.E. # 95