

PLAT NO. 100  
AUG 19 1997  
WATER RESOURCES DEPT.  
SALFORD DIVISION

THORNTON LAKE

PUMP:  
LOCATED NORTH 170' & EAST 378'  
FROM AN ANGLE POINT IN THE  
NORTH LINE OF D.L.C. No. 59.

NORTH 170' E



EAST 378' E

D.L.C. No. 59

NE 1/4, NW 1/4  
SE 1/4, NW 1/4

SCALE: 1" = 100'

EXPIRATION DATE: 12/31/97

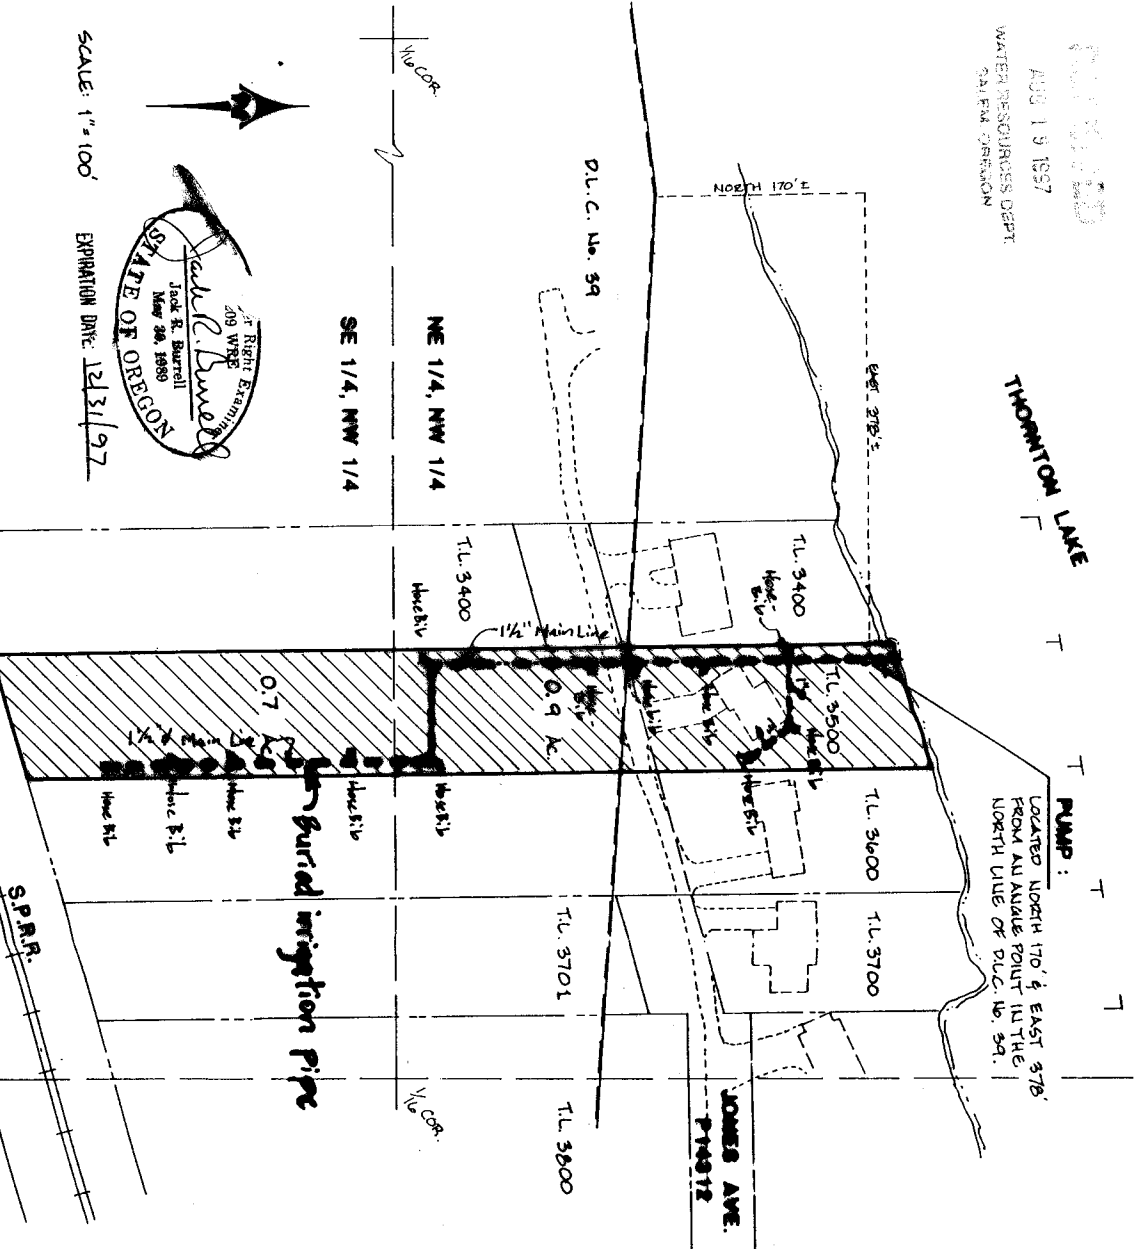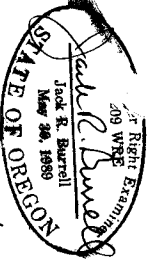

FINAL PROOF SURVEY

Under

APPLICATION S-73233

in the name of

JACK C. WHITE  
1111 Jones Avenue NW  
Albany, OR 97321

Surveyed By:  
K & D ENGINEERING, INC.  
August 18, 1997

Tax Lot: 3500 (11.4W-1BA)  
Source: Thornton Lake

Proposed Acres in Section 1  
Under S-73233 is 1.6 acres broken down by quarter-quarter  
Section as follows:

NE 1/4 NW 1/4	=	0.9 Acres
SE 1/4 NW 1/4	=	0.7 Acres
<b>TOTAL</b>	<b>=</b>	<b>1.6 ACRES</b>

JACK R. BURRELL, BEING DULY SWORN AS A WATER RIGHT EXAMINER, LICENSE NO. 209, HAVE PREPARED THIS MAP FOR JACK C. WHITE ON THIS 18TH DAY OF AUGUST 1997. THE AREAS HATCHED REPRESENT THE ACRES BEING IRRIGATED AT THE TIME OF THE SURVEY.  
PREPARATION OF THIS MAP IS FOR THE PURPOSE OF IDENTIFYING THE LOCATION OF THE WATER RIGHT ONLY AND HAS NO INTENT TO PROVIDE DIMENSIONS OR LOCATION OF PROPERTY OWNERSHIP LINES.

**K&D** ENGINEERING, INC.  
202 NW HICKORY STREET  
POST OFFICE BOX 728  
ALBANY, OREGON 97321

**WHITE WATER RIGHT**  
LOCATED IN  
SEC. 1, T.11S, R.4W, W.M., BENTON COUNTY, OR.

DSGN. BY: N/A  
DWG. BY: M.M.S.  
CHK. BY: J.R.B.  
SCALE: 1" = 100'  
DATE: JAN 7, 1995  
PROJECT NO: 92-144

SHEET NO.  
**1**