


The land to be irrigated and the diversion point are exactly the same for this new application.

Chris Lindseth

T. 13 S. R. 5 W. W. M.

Application No. 72740
Permit No. 51672

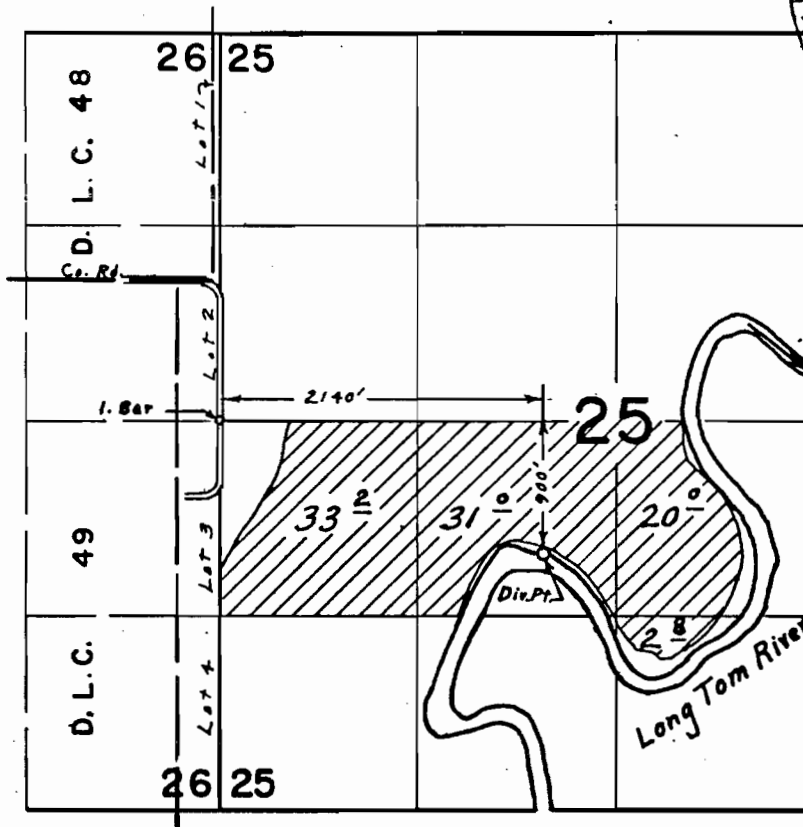

RECEIVED

JUL 30 1996

WATER RESOURCES DEPT.
SALEM, OREGON

FINAL PROOF SURVEY
UNDER

Application No. 42521 Permit No. 31776
IN NAME OF

HERMAN & LINNIE LINDSETH

Surveyed Sept. 3, 1970, by L. E. Gould