

RECEIVED

Map for: Tom Schmidt

AUG 13 1992

Location: The N.E. 1/4 & N.W. 1/4 & S.E. 1/4 & S.W. 1/4 of the N.W. 1/4 and also the N.W. 1/4 & N.E. 1/4 & S.E. 1/4 of the S.W. 1/4 and also the N.W. 1/4 of the S.E. 1/4 of Section 6, T.5 S., R.4 W., W.M., and also the S.E. 1/4 of the N.E. 1/4 and the N.E. 1/4 of the S.E. 1/4 of Section 1, T.5 S., R.5 W., W.M., J. A. Cornwall D.L.C No.64, Yamhill County, Oregon.

WATER RESOURCES DEPT.
STATE OF OREGON

Tax Lot:

Application No.

Date : 7 July 1992


By : Matt Dunckel & Assoc.
19010 Baker Creek Rd.
McMinnville, Oregon 97128
Phone : 472-7904

LEGEND:

----- = Property line
———— = Section line
- - - - - = "40" line



North

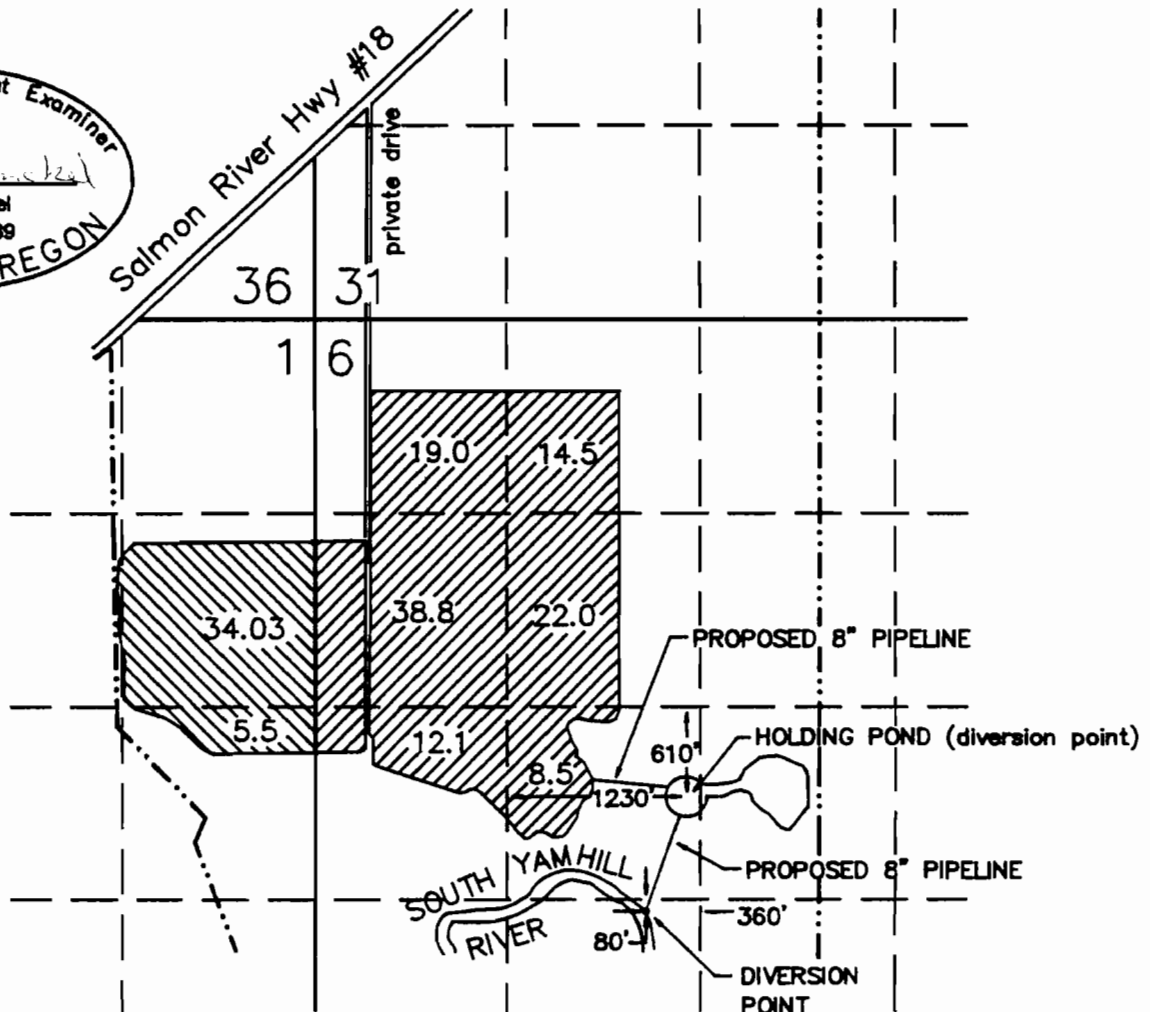

Scale : 1" = 1320'

See orig. map for distances in feet for POD #685
from NW corner, sect. 6

HAS BEEN
REVISED

Map for: Tom Schmidt

owner: B. A. McPhillips

Located in W 1/2 Section 6, T5S,
R. 4W., E 1/2 Section 1, T. 5S., R. 5W.
Yamhill County, Oregon


SAR - shows
distances for POD
from NW corner, Sect 6

Tax Lot: 5406-200

Date: 15 March 1990

By: Matt Dunkel
19010 Baker Cr. Rd.
McMinnville, 97128
Phone: 472-7904

Application No. R-70270 & 70187
Permit No.

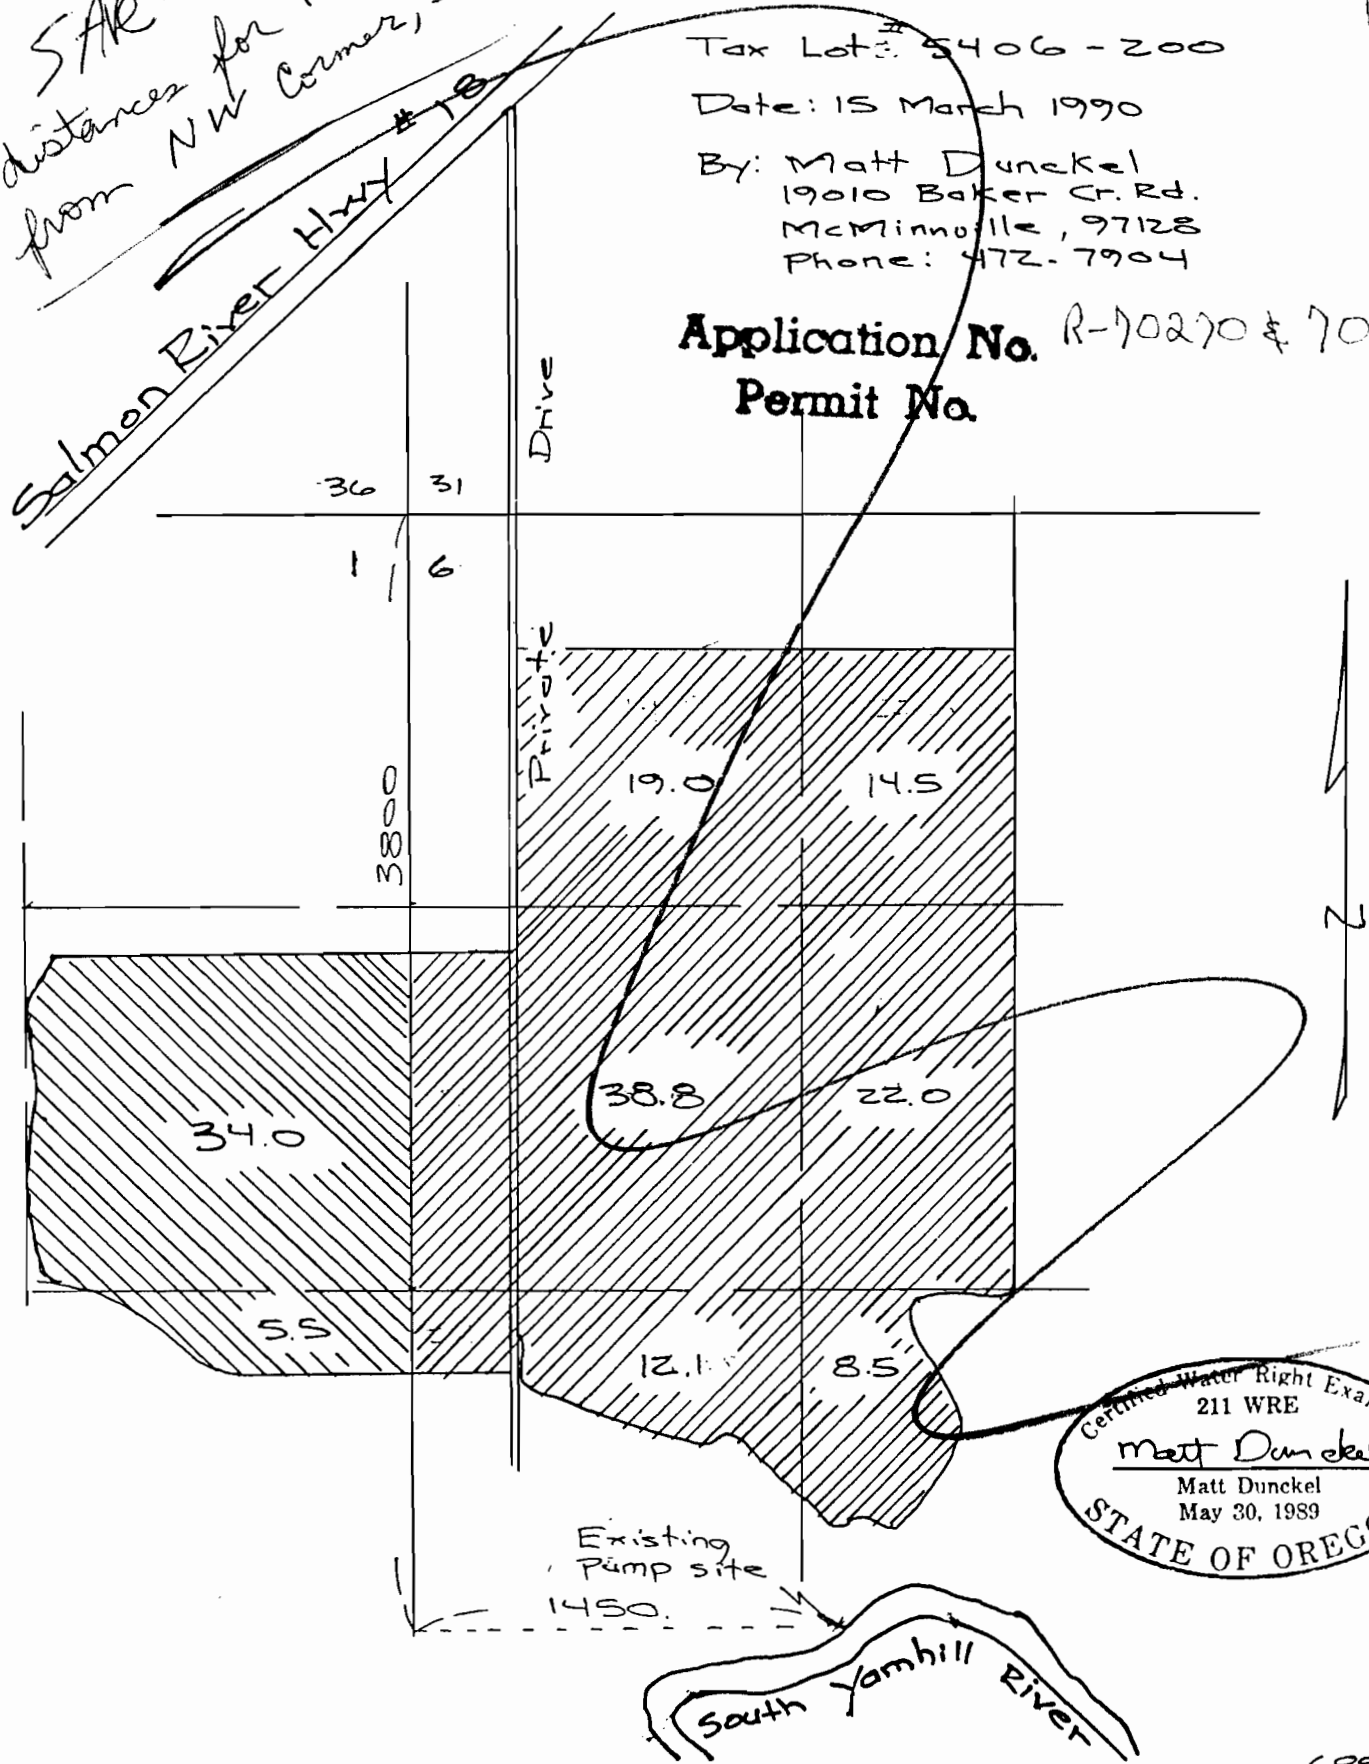

Certified Water Right Examiner
211 WRE
Matt Dunkel
Matt Dunkel
May 30, 1989
STATE OF OREGON