

T.3 S. 36 31
T.4 S. 1 6
YAMHILL COUNTY
CLACKAMAS COUNTY

CLACKAMAS COUNTY
YAMHILL COUNTY

NW 1/4 OF THE NW 1/4
SW 1/4 OF THE NW 1/4
SECTION 6
T4S, R1W, WM
YAMHILL COUNTY, OREGON

AREA OF BENEFICIAL USE

TRANSFER T-6597 (REF. #59990)

PERMIT #51725 (APPL.# 70634)

SEC.	1/4 1/4	ACRES	IRRIG.	OWRD REF.
6	NW NW	0.37		T-6597
6	SW NW	1.93		T-6597
6	SW NW	1.74		S-51725
TOTAL		4.04		

INTAKE IS LOCATED 2000 FEET SOUTH AND 1800 FEET EAST OF THE NORTHWEST CORNER OF SECTION 6, TOWNSHIP 4 SOUTH RANGE 1 WEST, WM, YAMHILL COUNTY, OREGON

RECEIVED

OCT 02 1996

RESOURCES DEPT
SALEM, OREGON

NW OF NW
IRRIG AC=0.37 AC

TAX LOT 4106-601 YAMHILL COUNTY

TAX LOT 4106-600 YAMHILL COUNTY

NW1/4 OF NW1/4

NE1/4 OF NW1/4

SW1/4 OF NW1/4

SE1/4 OF NW1/4

SW OF NW
IRRIG AC=1.93 AC

DRIVEWAY

BARN

HOUSE

AUTHORIZED POINT OF DIVERSION (#59990)
2160' SOUT & 240' EAST FROM NW CORNER OF
SECTION 6

SEE FIGURE
2 OF 2

RELOCATED POINT OF DIVERSION
2060' SOUTH & 1510' EAST FROM NW
CORNER OF SECTION 6

SW OF NW
IRRIG AC=1.74 AC


R.2 W.
R.1 W.

YAMHILL COUNTY
MARION COUNTY


WILLAMETTE RIVER

SE1/4NW1/4

SHERWOOD 7.5' QUAD

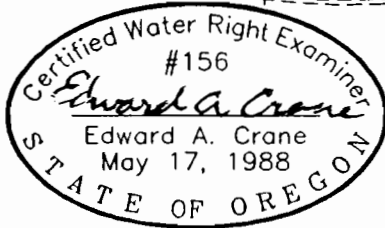

Signed 9-27-96
Renewal 12/31/97

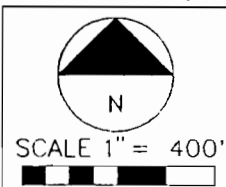

SURVEYED SEPT. 12, 1996
BY EDWARD A. CRANE, CWRE

PREPARATION OF THIS MAP WAS FOR THE PURPOSE
OF IDENTIFYING THE LOCATION OF THE WATER RIGHTS
ONLY AND HAS NO INTENT TO PROVIDE DIMENSIONS
OR LOCATION OF PROPERTY OWNERSHIP LINES.

PERMIT 51725, APPL. 70634
TRANSFER OF WATER RIGHT
T-6597, CERTIFICATE 59990

PREPARED BY EDWARD A. CRANE, CWRE

DATE

SEPT. 1996

PROJECT NO.

223-001



CRANE & MERSETH

Engineering/Surveying

SUITE "D"
6566 SE LAKE ROAD
MILWAUKIE, OREGON 97222

BUS: (503) 654-2005
FAX: (503) 654-2575


PORTION OF CERTIFICATE NUMBER 59990

PERMIT NUMBER 51725 IN THE NAME OF

PETER & COLLEEN HANSEN
36420 NE WILSONVILLE ROAD
NEWBERG, OR 97132 (TEL: 503-625-2417)

FIGURE

1/2

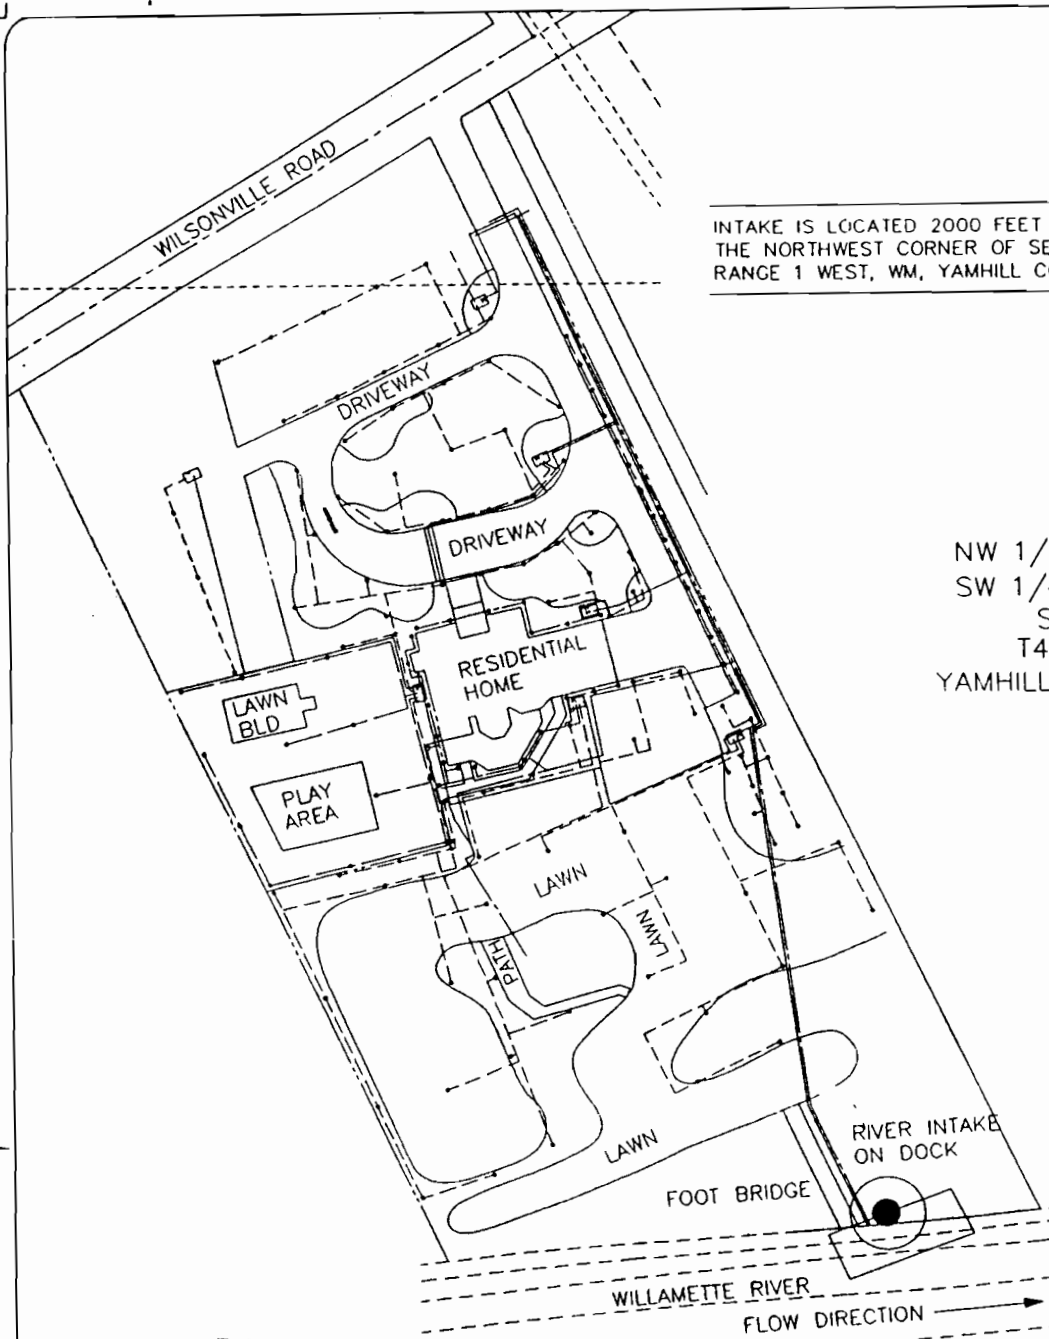

INTAKE IS LOCATED 2000 FEET SOUTH AND 1800 FEET EAST OF THE NORTHWEST CORNER OF SECTION 6, TOWNSHIP 4 SOUTH RANGE 1 WEST, WM, YAMHILL COUNTY, OREGON

RECEIVED


OCT 02 1996

WATER RESOURCES
LEWIS & CLARK

NW 1/4 OF THE NW 1/4
SW 1/4 OF THE NW 1/4
SECTION 6
T4S, R1W, WM
YAMHILL COUNTY, OREGON

SYSTEM DATA


4" JACUZZI PUMP MODEL NO. 15S4 25 10-52 (25 GPM)
1-1/2" PVC MAIN PIPELINE
RAINBIRD SPRINKLERS
SPRINKLER HEADS ON 1/2" GALVANIZED PIPE 5' OFF GROUND (ON RISERS ETC)
SYSTEM SUPPLIED BY DAVID NOE LANDSCAPING (TEL: 503-638-6212)
19835 SW 49TH, TUALATIN, OR

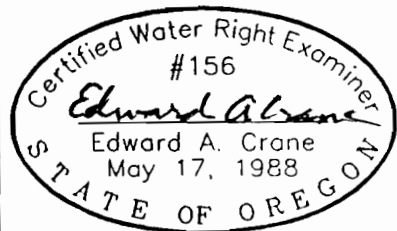

Renewal 12/31/97
Signed *9.27.96*

SURVEYED SEPT. 12, 1996
BY EDWARD A. CRANE, CWRE

E:\CADD\223-001\22300101.DWG 9/27/96 EAC

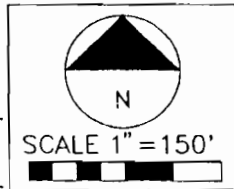

PREPARATION OF THIS MAP WAS FOR THE PURPOSE OF IDENTIFYING THE LOCATION OF THE WATER RIGHTS ONLY AND HAS NO INTENT TO PROVIDE DIMENSIONS OR LOCATION OF PROPERTY OWNERSHIP LINES.

PERMIT 51725, APPL. 70634
TRANSFER OF WATER RIGHT
T-6597, CERTIFICATE 59990

PREPARED BY EDWARD A. CRANE, CWRE

DATE

SEPT. 1996

PROJECT NO.
223-001



CRANE & MERSETH
Engineering/Surveying
SUITE "D"
6566 SE LAKE ROAD
MILWAUKIE, OREGON 97222
BUS: (503) 654-2005
FAX: (503) 654-2575

PORTION OF CERTIFICATE NUMBER 59990
PERMIT NUMBER 51725 IN THE NAME OF:

PETER & COLLEEN HANSEN
36420 NE WILSONVILLE ROAD
NEWBERG, OR 97132 (TEL: 503-625-2417)

FIGURE

2/2