

**WATER RIGHTS SURVEY FOR
HIDDEN VALLEY HIGH SCHOOL**


ON MAP 37-5-30, TAX LOTS 100-94 & 200-94
LYING WITHIN SECTIONS 19 & 30,
TOWNSHIP 37 SOUTH, RANGE 5 WEST
OF THE WILLAMETTE MERIDIAN
JOSEPHINE COUNTY, OREGON

SURVEY WORK MAP


RECEIVED

MAR 30 1994

WATER RESOURCES DEPT.
SALEM, OREGON

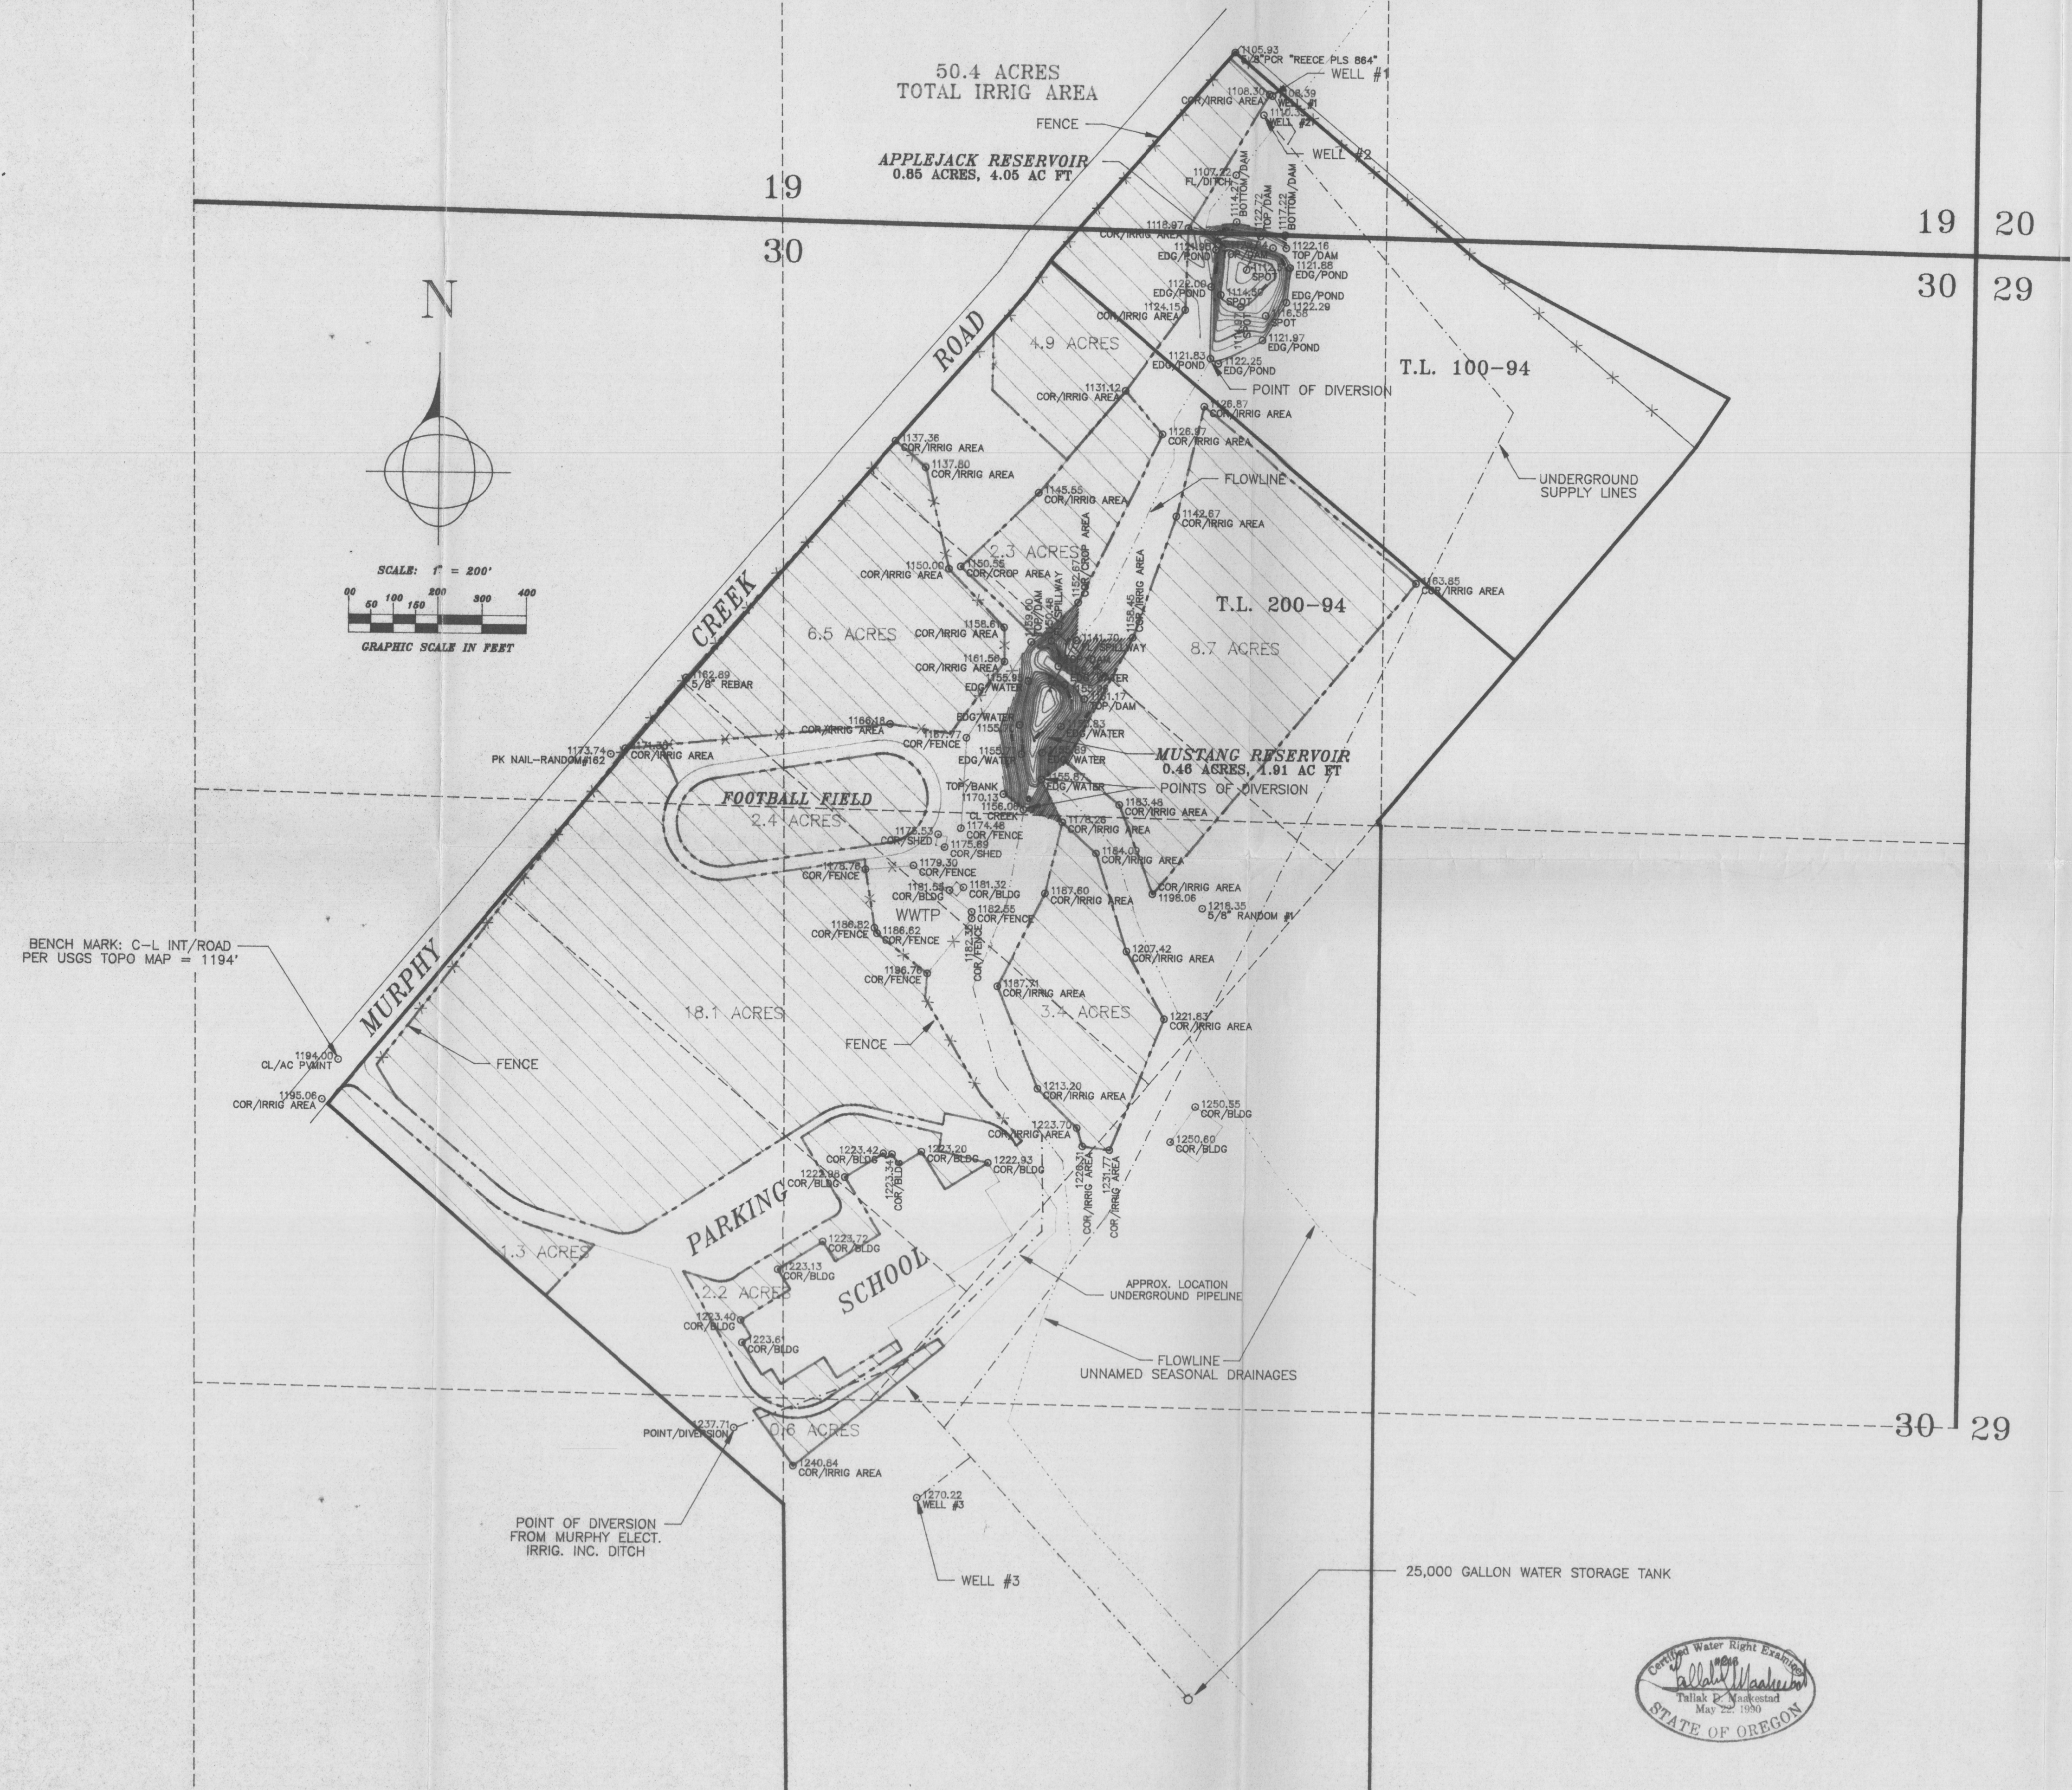

REGISTERED
PROFESSIONAL
LAND SURVEYOR
Tallak D. Maakestad
OREGON
JAN 23 1990
TALLAK D. MAAKESTAD
3429

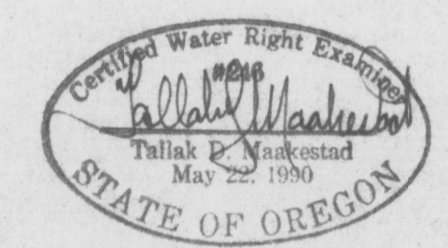

MAAKESTAD ASSOCIATES, INC. * SURVEYING * MAPPING * WATER RIGHTS *

303 N.E. "E" STREET, GRANTS PASS, OREGON 97526 (503) 471-1113

JOB #: 93006	PREPARED FOR: JOSEPHINE COUNTY SCHOOL DISTRICT
DATE: 06/19/93	FOR: 126 RINGUETTE STREET
DRAWN BY: TLH	GRANTS PASS, OR 97527 (503)476-6304
FILE: 93006	