


T. 1S., R. 1E., S.E. 1/4 SEC. 3 W.M.

THE PURPOSE OF THIS MAP IS TO IDENTIFY THE WATER RIGHT. IT IS NOT INTENDED TO PROVIDE LEGAL DIMENSIONS OR TO SHOW THE LOCATION OF PROPERTY OWNERSHIP LINES.

SCALE: 1"=400'

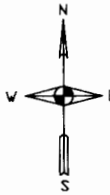

1320±

POINT OF DIVERSION

BULL RUN PIPE LINE R/W  
TAX LOT 50

TAX LOT 21

TAX LOT 69

SE LINCOLN

SE GRANT

SE CARUTHERS

SE 4TH AVE


MARQUAM BRIDGE

HARBOR LINE

WILLAMETTE RIVER

HARBOR LINE

1420±

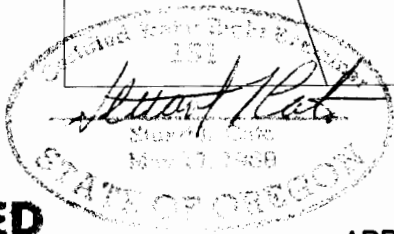

3 2  
10 11

**FINAL PROOF SURVEY**

UNDER

APPLICATION NO. S-73310 PERMIT NO. 51930

IN THE NAME OF

OREGON MUSEUM OF SCIENCE AND INDUSTRY

1945 SE WATER AVE.

PORTLAND, OR 97214-3354

**RECEIVED**

JUN 05 2000

ER RESOURCES DEPT  
SALEM, OREGON

**ALPHA ENGINEERING INC.**  
PLANNING DEVELOPMENT SERVICES SURVEYING  
OFFICE 503-452-8003 • FAX 503-452-8043  
PLAZA WEST • SUITE 230 • 9600 SW OAK  
PORTLAND, OR 97223

SURVEYED MAY 2000 BY STUART L. CATO CWRE-151

558001-1

REVIEWED BY: SLC

DATE: 5/8

PROJECT: 558-001

JOB: OMSI

OMSI/WR

DRAWN BY: MHH

DRAWING: ALPHA/OMSIWR.DWG

DATE: 5/8

DRAWING NO.