T 6 S, R 1 W, W.M.

MARION COUNTY, OREGON

RECEIVED
SEP 10 1993
WATER RESOURCES DEPT
SALEM, OREGON

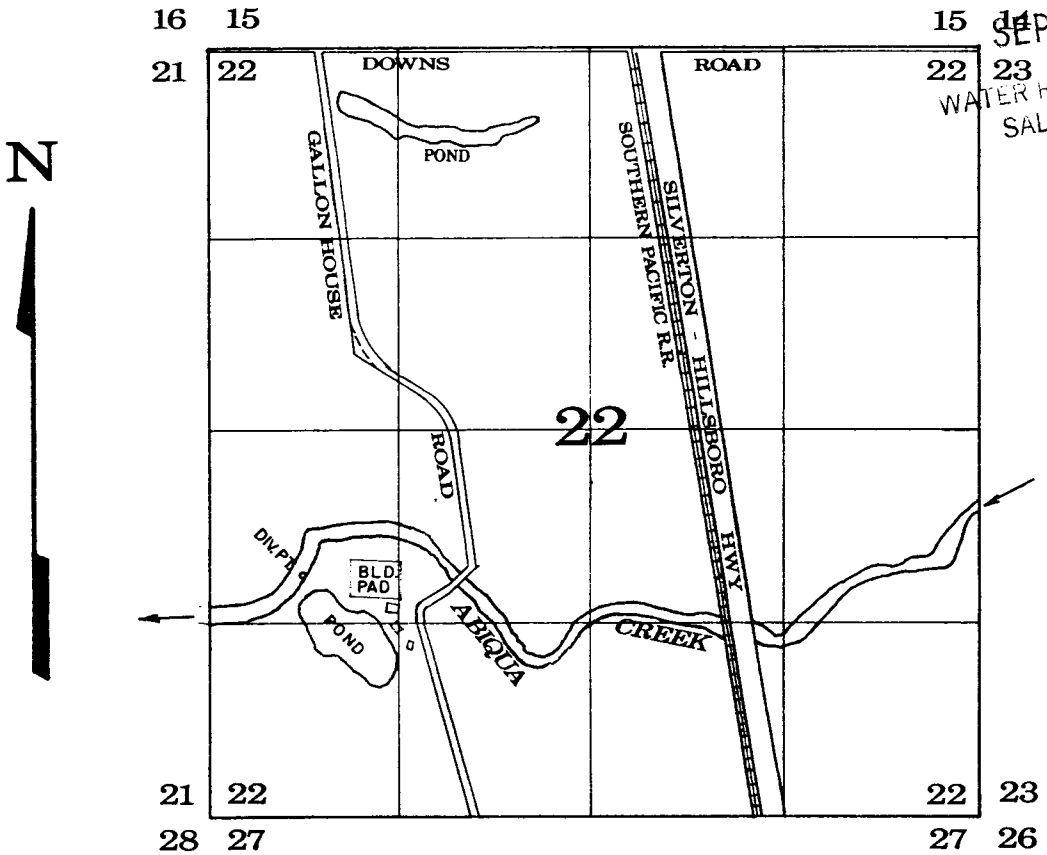

DIV. PT. NW ¼ SW ¼, SECTION 22, T.6S., R.1W., W.M.

CENTER OF POND 940'E & 1270'N FROM THE SW CORNER OF SEC 22 T.6S., R.1W., W.M.

Application No. ~~S 72222~~ 33615 Permit No. ~~26580~~ 51992

FRED RHYME

Scale 1" = 1320'

January 24, 1992

REVISED: SEPTEMBER 9, 1993

Certified Water Right Examiner
#208 WRE
Corbey Boatwright
Corbey Boatwright
May 30, 1989
STATE OF OREGON

APPLICATION TO APPROPRIATE SURFACE WATER

NOTE: This map is for the purpose of identifying the location of water rights and has no intent to dimension or locate property ownership lines.