

Application No. 72738
Permit No. 52054


52054
pc
RECEIVED

SEP 21 1992

WATER RESOURCES DEPT.
SALEM, OREGON

T. 19 S., R. 31 E., W.M.

Silvies E Miso
9-28-1992

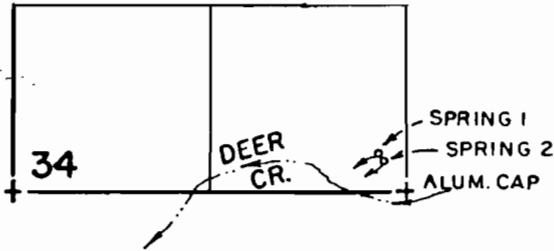

SPRING LOCATIONS FROM S1/4 CORNER SEC. 34

SPRING 1 - 225' N, 140' W
SPRING 2 - 180' N, 110' W

THE PURPOSE OF THIS MAP IS TO IDENTIFY THE LOCATION OF THE WATER RIGHT. IT IS NOT INTENDED TO PROVIDE INFORMATION RELATIVE TO THE LOCATION OF PROPERTY OWNERSHIP.

ARTHER & MARILYN WITTRUCK

WATER RIGHT APPLICATION MAP



Scale: 4" = 1 MILE

Date: SEPT 1992

Job: 1408

Dsn:

Drn: CHRIS

Ckd:



M. A. PALMER & SONS, INC.
ENGINEERING & SURVEYING
254 N. Alder - Box 61
Burns, Oregon 97720

Sht. No.

of 1

52054