
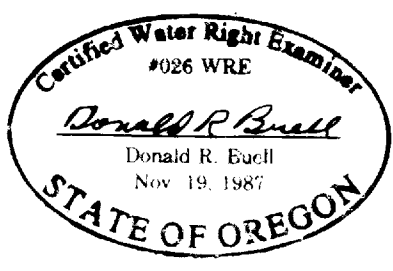


TOWNSHIP 9 SOUTH, RANGE 6 WEST, W.M.  
SW 1/4 Section I

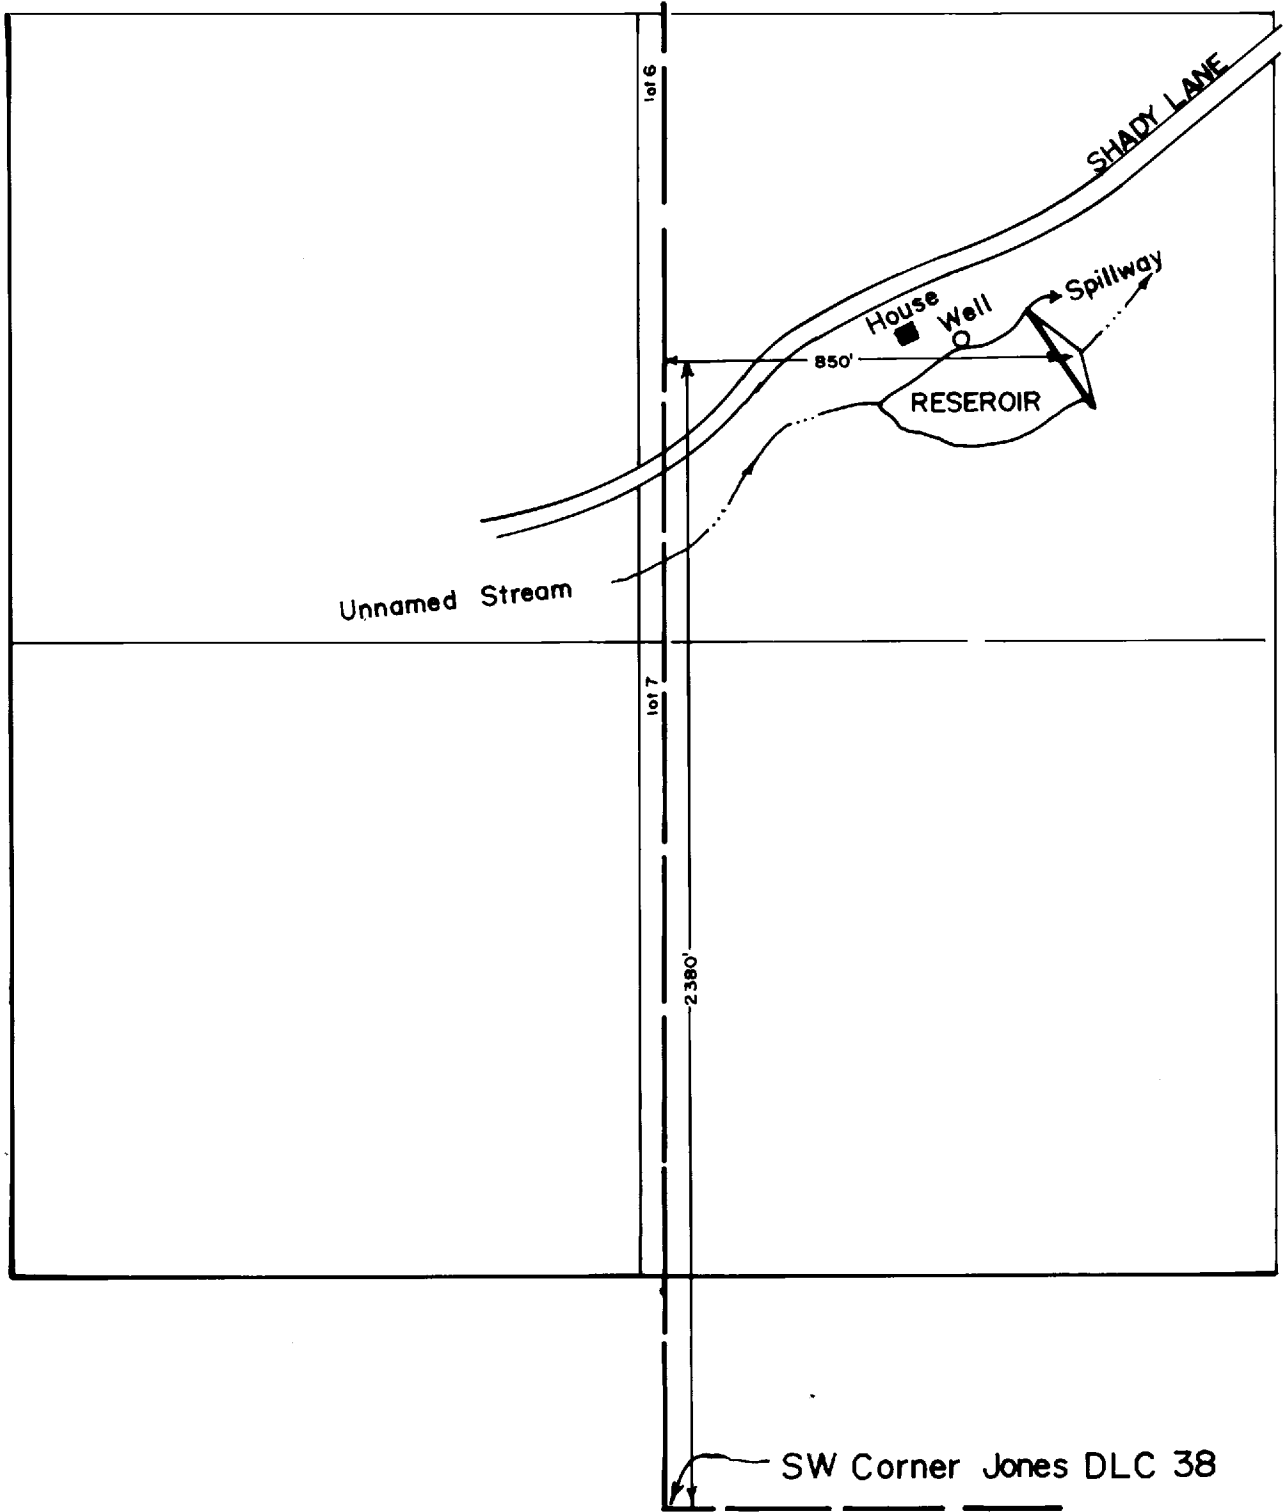

FINAL PROOF SURVEY  
under  
Appl. No. 73822, Per. No. 52062  
in name of  
RICHARD KINDWALL  
Nov. 11, 1999

**RECEIVED**  
MAY 05 2000  
WATER RESOURCES DEPT  
SALEM, OREGON

THIS MAP WAS PREPARED FOR THE PURPOSE OF IDENTIFYING THE LOCATION OF A WATER RIGHT ONLY AND IS NOT INTENDED TO PROVIDE LEGAL DIMENSIONS OR LOCATION OF PROPERTY OWNERSHIP LINES.