


Application No. 71869

Permit No. 52188

FINAL PROOF MAP

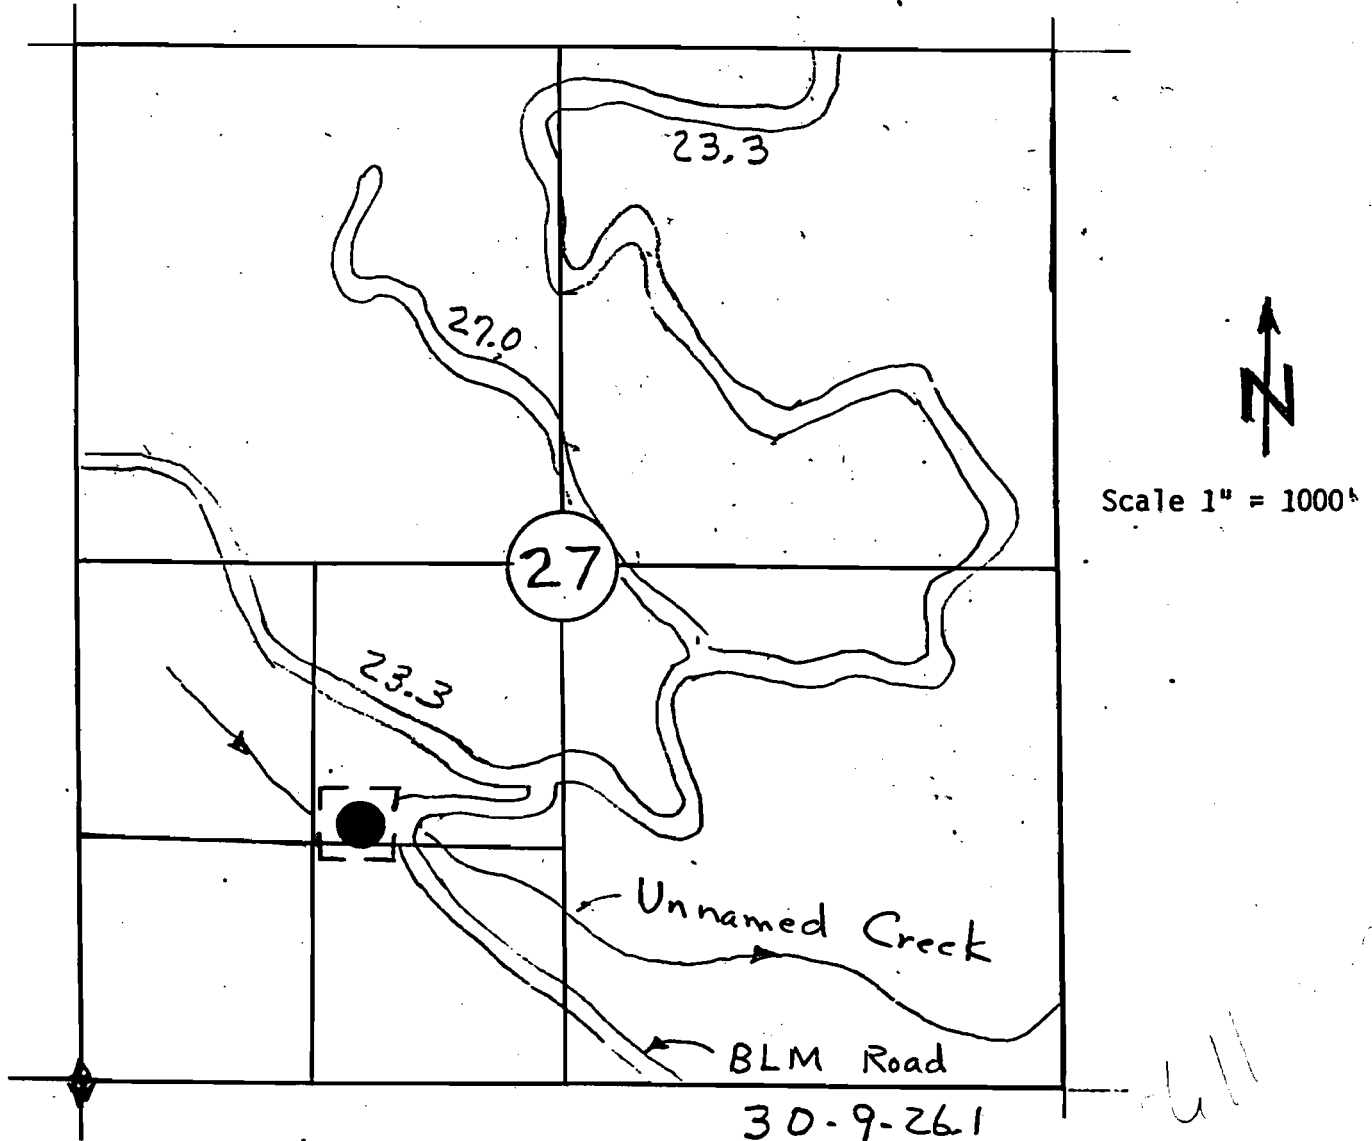


HONEY POT PUMP CHANCE
T30S R9W Sec 27
NE $\frac{1}{4}$, SW $\frac{1}{4}$

The point of diversion is located 1350 ft North and 1400 ft East from the Southwest Section corner of Section 27.

Coordinate Ties are based on aerial photo 2-2-9-89.



The map is shown for the purpose of water application and not property boundary.

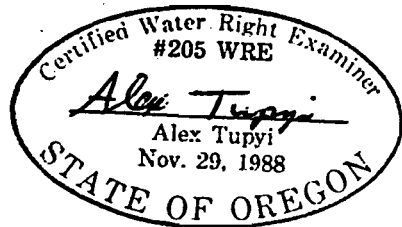

3-5-90