


Sec. (12) permit # 52224

RECEIVED

JUN 17 1996

Sec. (7)

WATER RESOURCES DEPT.
SALEM, OREGON

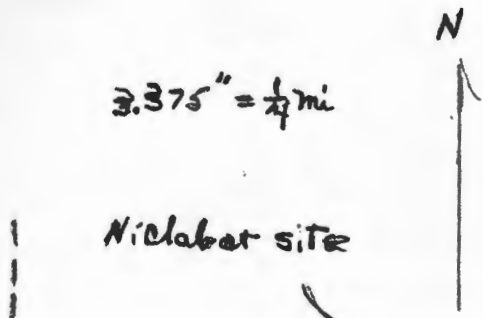

Nicholab site

Coon Cr
34 springs

T 145 R. 9W.
T 145 R. 8W.

N. 61° W
N. 57° W

300' River front

Alsea R. Hwy 34

6-26-96
JLD

LINCOLN CTY.

Sec. 12

Sec. 7

893'

BENTON CTY.

Sec. 13

Sec. 18

mile post 30

Cecil Ln

Sec. (13)

← To Bender Cr. Rd.

Alsea River - flow →

Sec. (18)

Bennet Cr. Road goes
ACROSS a BLM Bridge
9.2 miles west of Alsea on
Hwy 34

5035'E

← Alsea - Hwy 34 - 6wa/10post →
19.2 mi.

neighborhood map