


Application No. R-72542 + S 12543
Permit No. R-11801 + S 52267

T.2-S.R.4W.W.M.

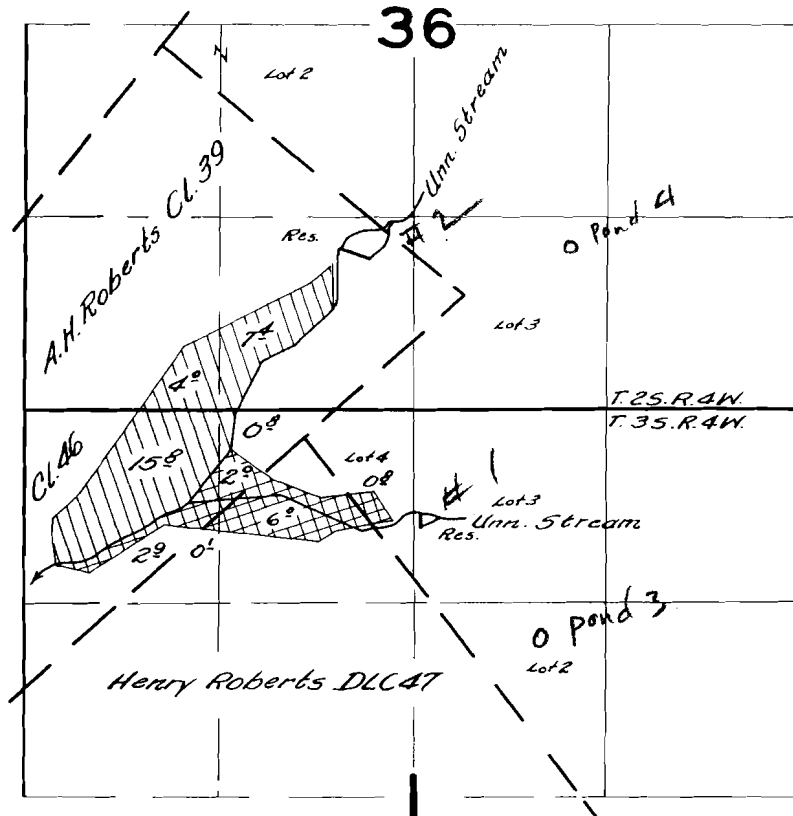

FINAL PROOF SURVEY
UNDER

Application No. ~~R-27783~~ ^{R-27784} Permit No. ~~R-1517~~ ^{R-1517} ~~22426~~ ²²⁴²⁶
IN NAME OF

JOHN A. JOHNSON & SON

Surveyed March 16 1959, by C.O. Bartels