


T 30 S. R 6 W. WM

SCALE 1" = 1320'

RECEIVED
SEP - 5 1990
WATER RESOURCES DEPT.
TALEM, OREGON

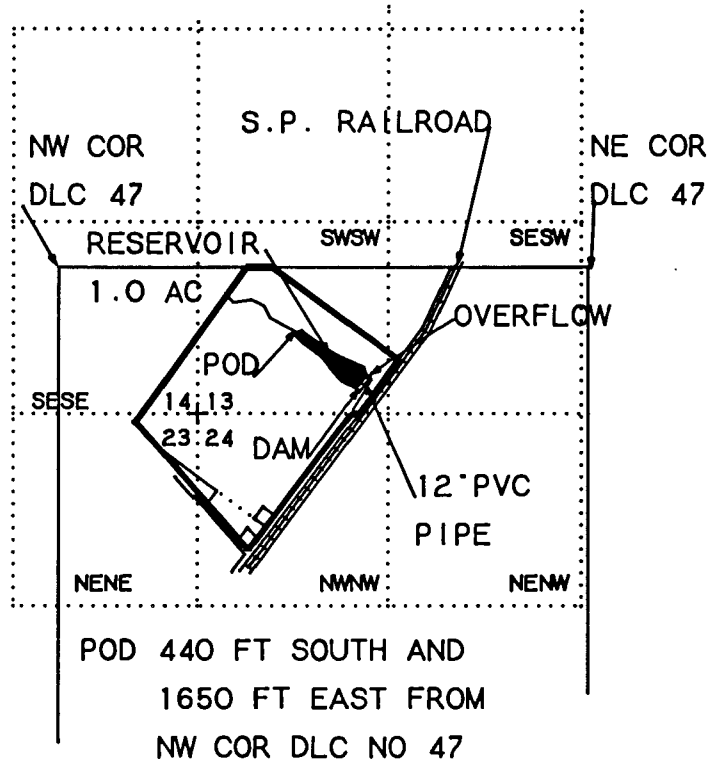

FINAL PROOF SURVEY
UNDER

Application No. ^{R. 70624} ~~70625~~ Permit No. 52224

IN NAME OF

GLENBROOK NICKEL COMPANY

Surveyed July 27, 1990 BY M E Farr

