



File: S-71144
Bob's Spring
South of South Fork
of Sprague River

Permit # 52171

RECEIVED

FEB -7 1986

WATER RESOURCES DEPT.,
SALEM, OREGON

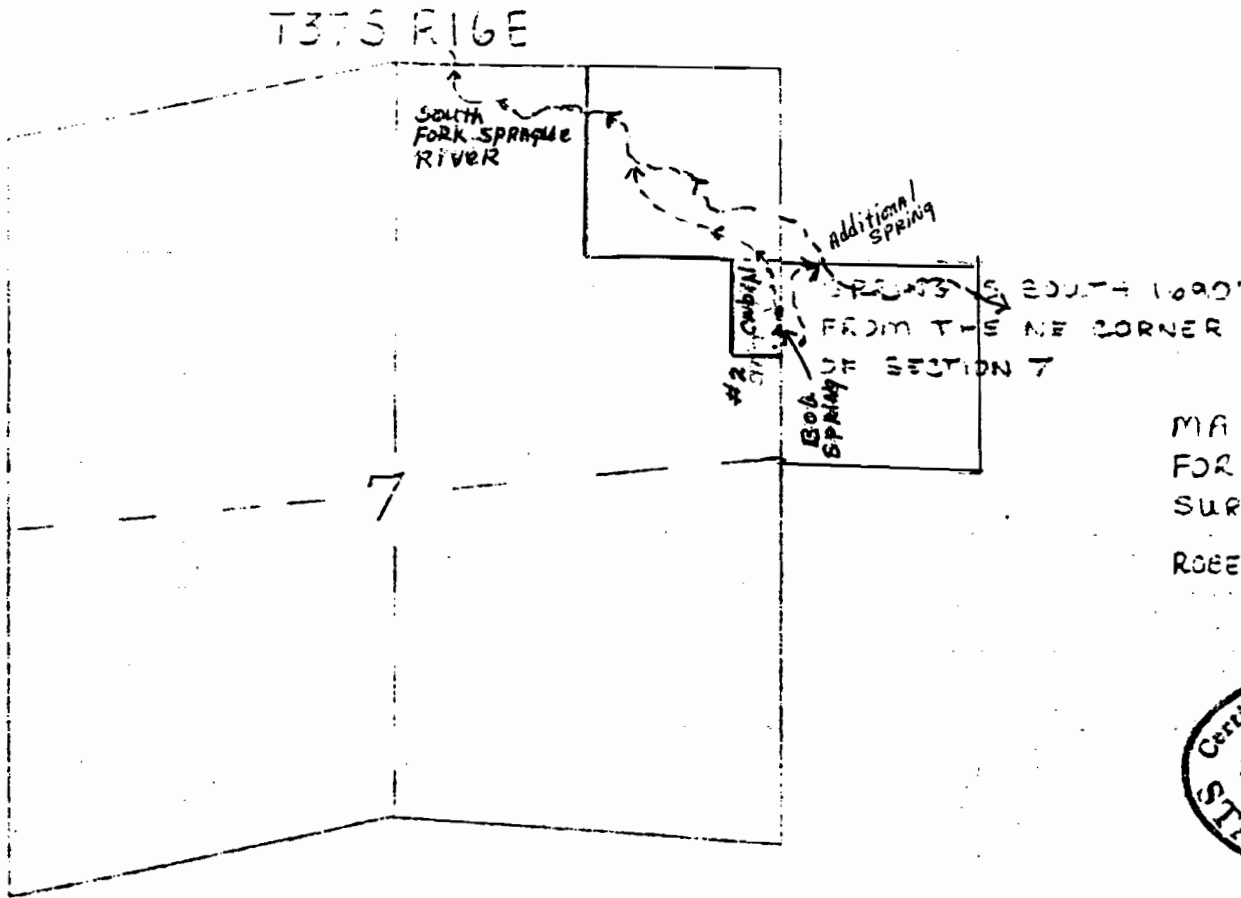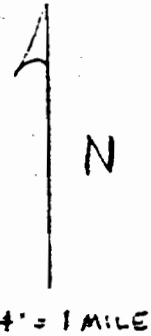

MAP TO ACCOMPANY APPLICATION
FOR A PERMIT TO APPROPRIATE
SURFACE WATER

ROBERT UTLEY ET AL

