




T3S, R45E, W.M.
1" = 1320'

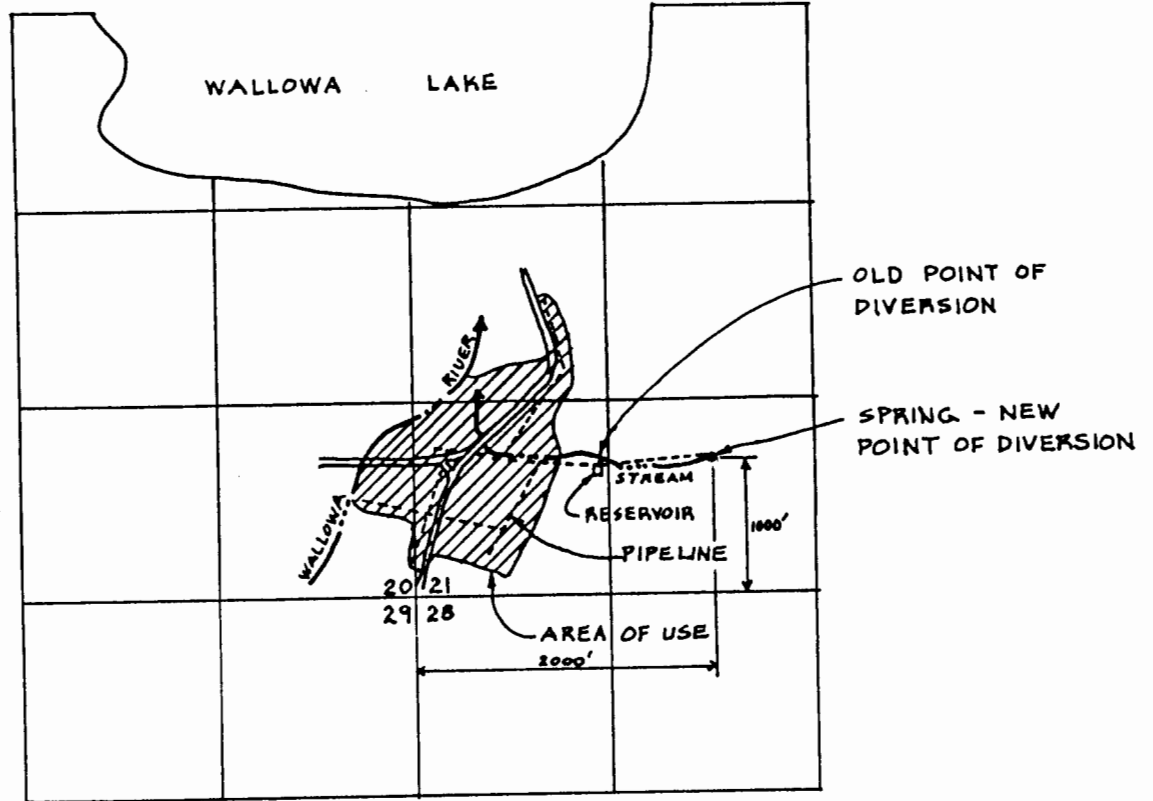

MAP FOR CHANGE IN POINT OF DIVERSION
FOR
CHIEF JOSEPH RESORT WATER DISTRICT
WITH
WATER RIGHT PERMIT NO. 17948

BASIS OF MAP: FINAL PROOF SURVEY MAP Dated 10-18-55

Permit No. 69523
Permit No. 52474