


FINAL PROOF MAP

RECEIVED

JUL 26 1990

WATER RESOURCES DEPT.  
SALEM, OREGON

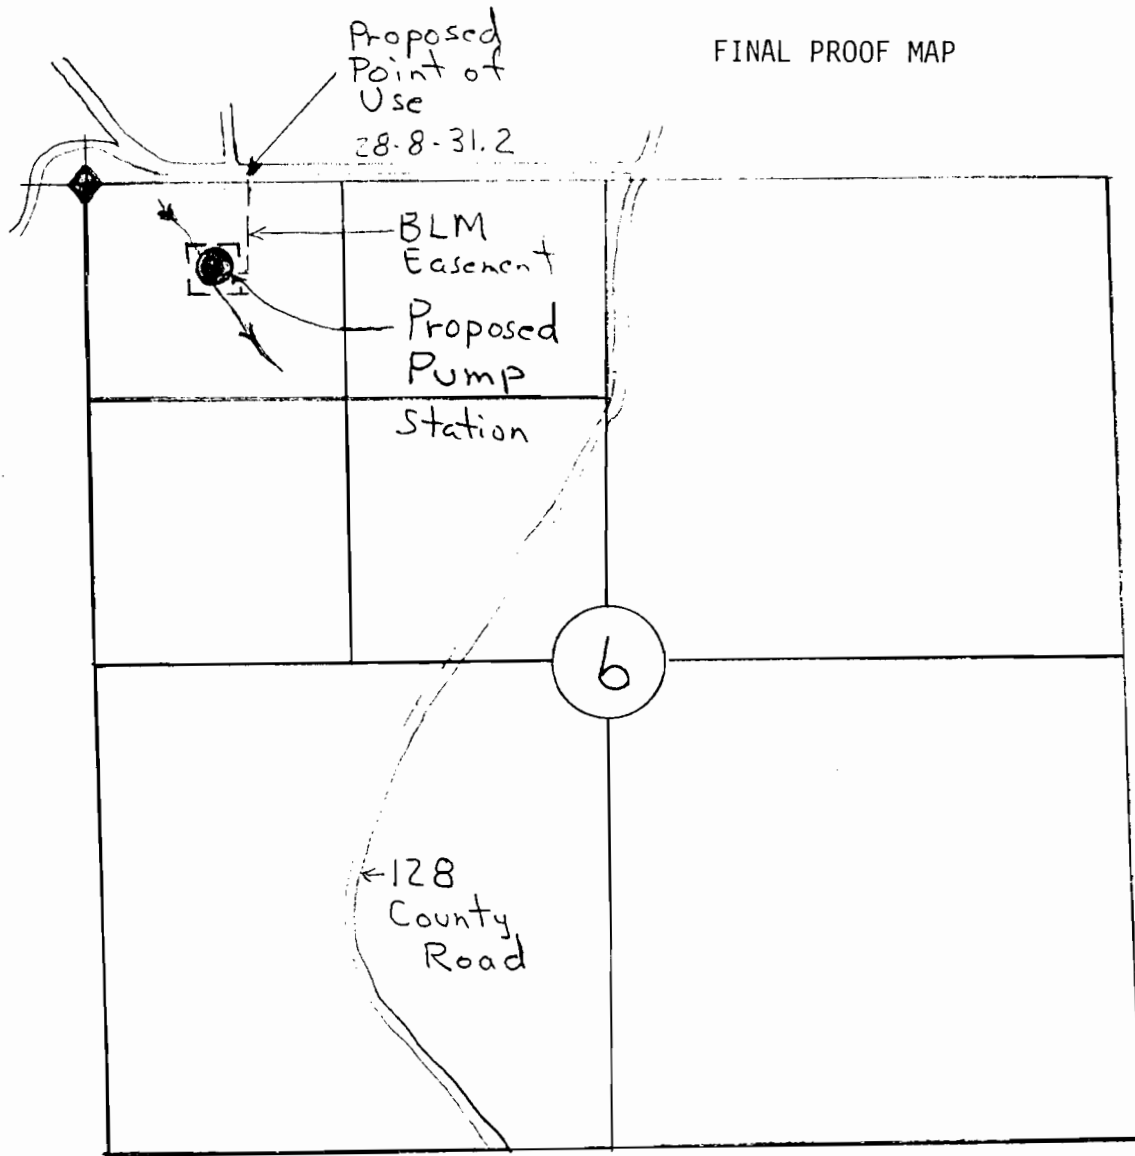

Scale 1" = 1000'

BLOOD DROP PUMP CHANCE  
T29S R8W Sec 6  
NW $\frac{1}{4}$  NW $\frac{1}{4}$


This pond is located on private land BLM has a 10 ft wide easement as shown,

The proposed pump station is located 460 ft South and 705 ft East from the Northwest Section corner of Section 6. The proposed point of use is located 10 ft North and 835 ft East from the Northwest Section corner of Section 6.

The map is shown for the purpose of water application and not property boundary.

Coordinate Ties are based on aerial photo 2-5-23-89.

Application No. 70520  
Permit No. 52480

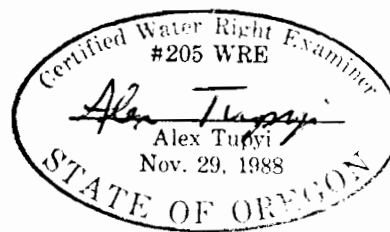

3-5-90