


T.30 S., R.6 W., W.M.

SECTION 26

AUG - 8 1994

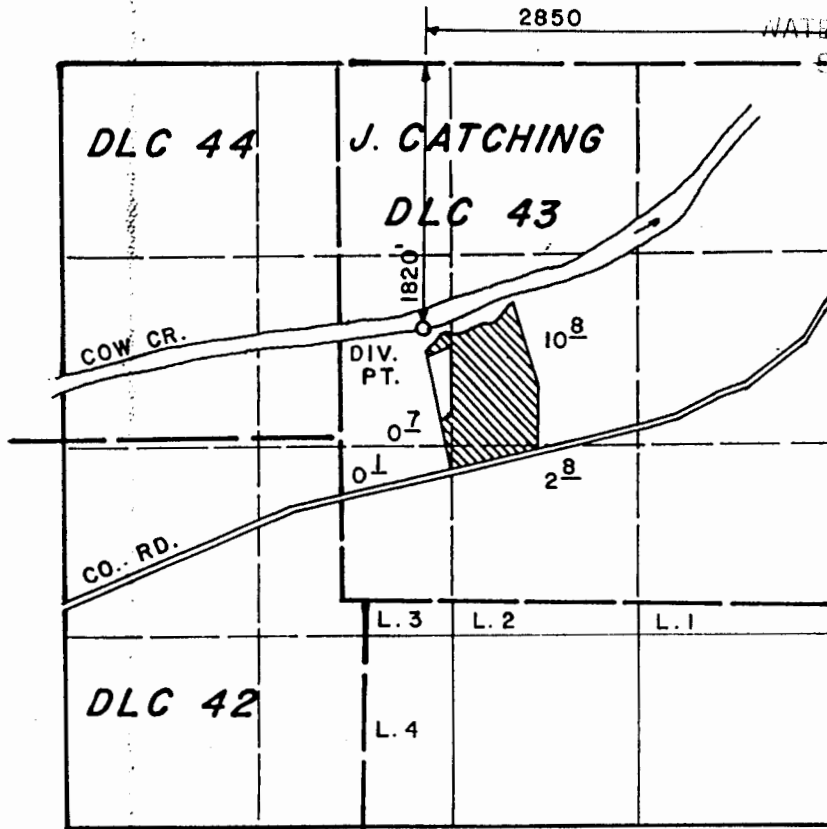

74407
52652

SCALE: 4" = 1 MILE

FINAL PROOF SURVEY
UNDER

Application No. 68018... Permit No. 48462
IN NAME OF

THOMAS H. IRELAND

Surveyed JUNE 23, 1988, by J. M. SCHMORDE.