


No. S-72396

Permit No. 52661

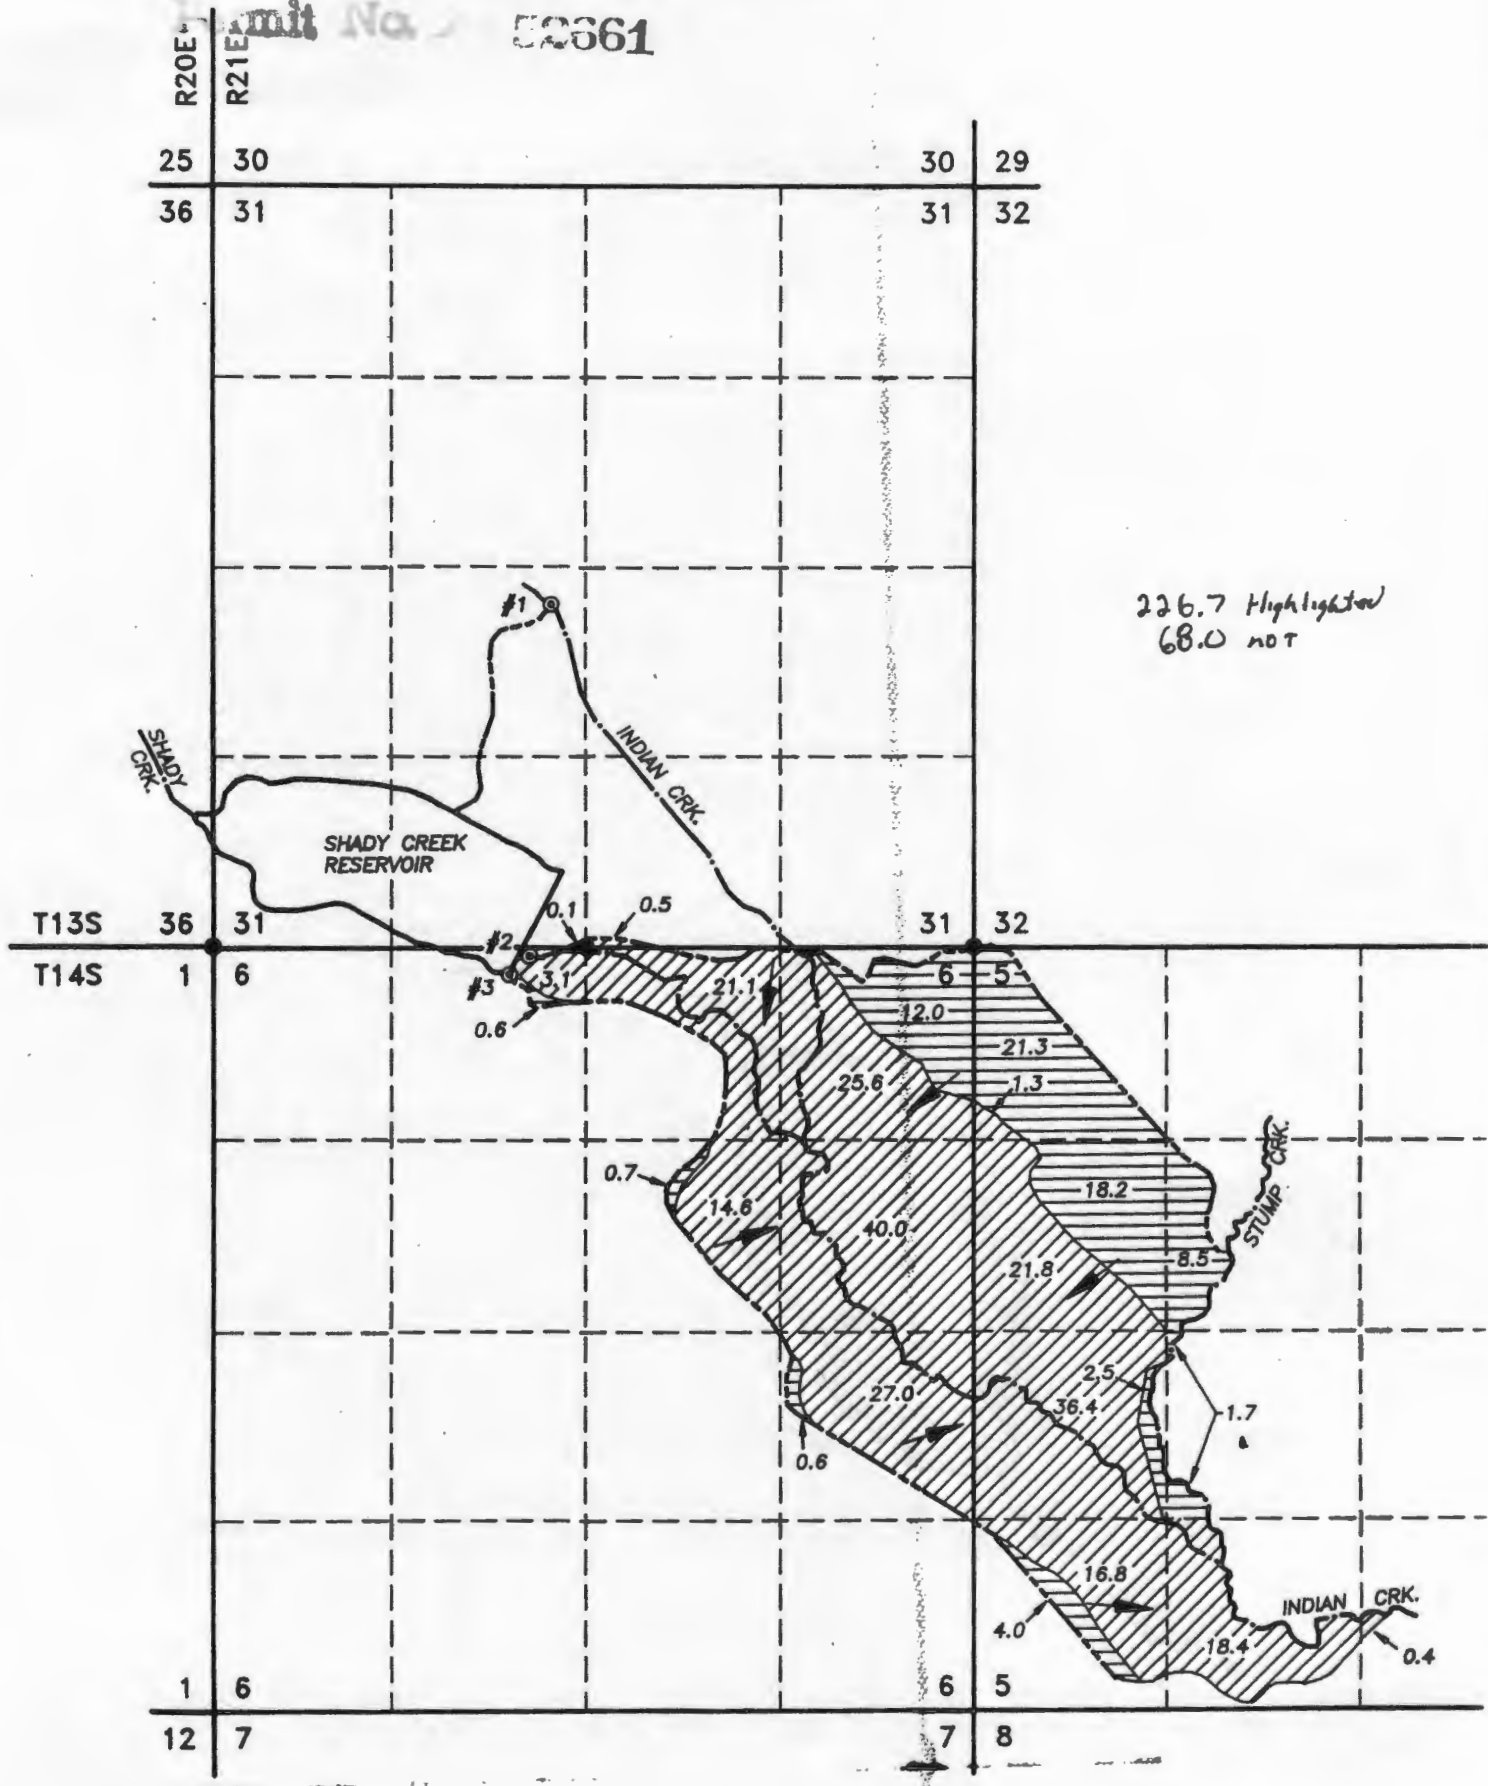

226.7 Highlighted
68.0 NOT