


PARADISE BAR LODGE

T 33S R 11W

T 33S R 10W

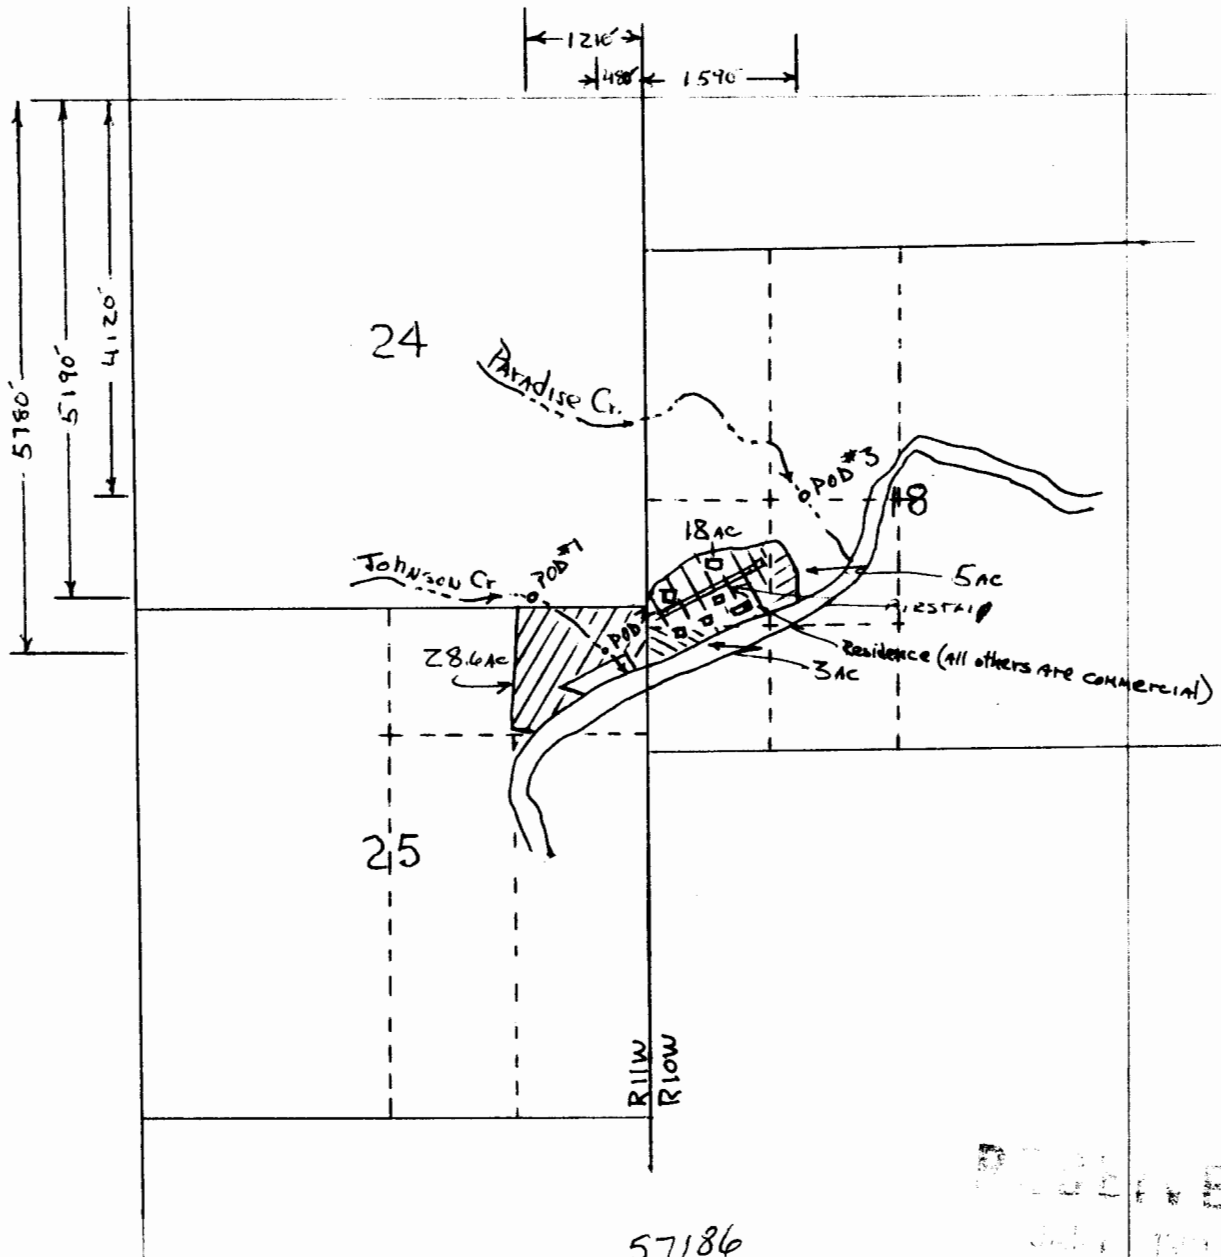

57186

Application No.  
Permit No.

RECEIVED  
 JUL 1 1991  
 WATER RESOURCES DEPT  
 SALEM, OREGON

Note: There are no maps of this remote area available other than USGS quads sheets. This map was drawn using an aerial photo as a guide and the map should be fairly accurate.