


RECEIVED
AUG 24 1995
DEPARTMENT OF
LAND AND FORESTRY
SALEM, OREGON

Application No. *P-80591*
Permit No. 52725

*p is the pond location
water to be used in section
3, 5, 7, 9, 11, 17, 19, 21, 23, 25, 27
R6W 29, 31, 33, 35 of T235 R6W*

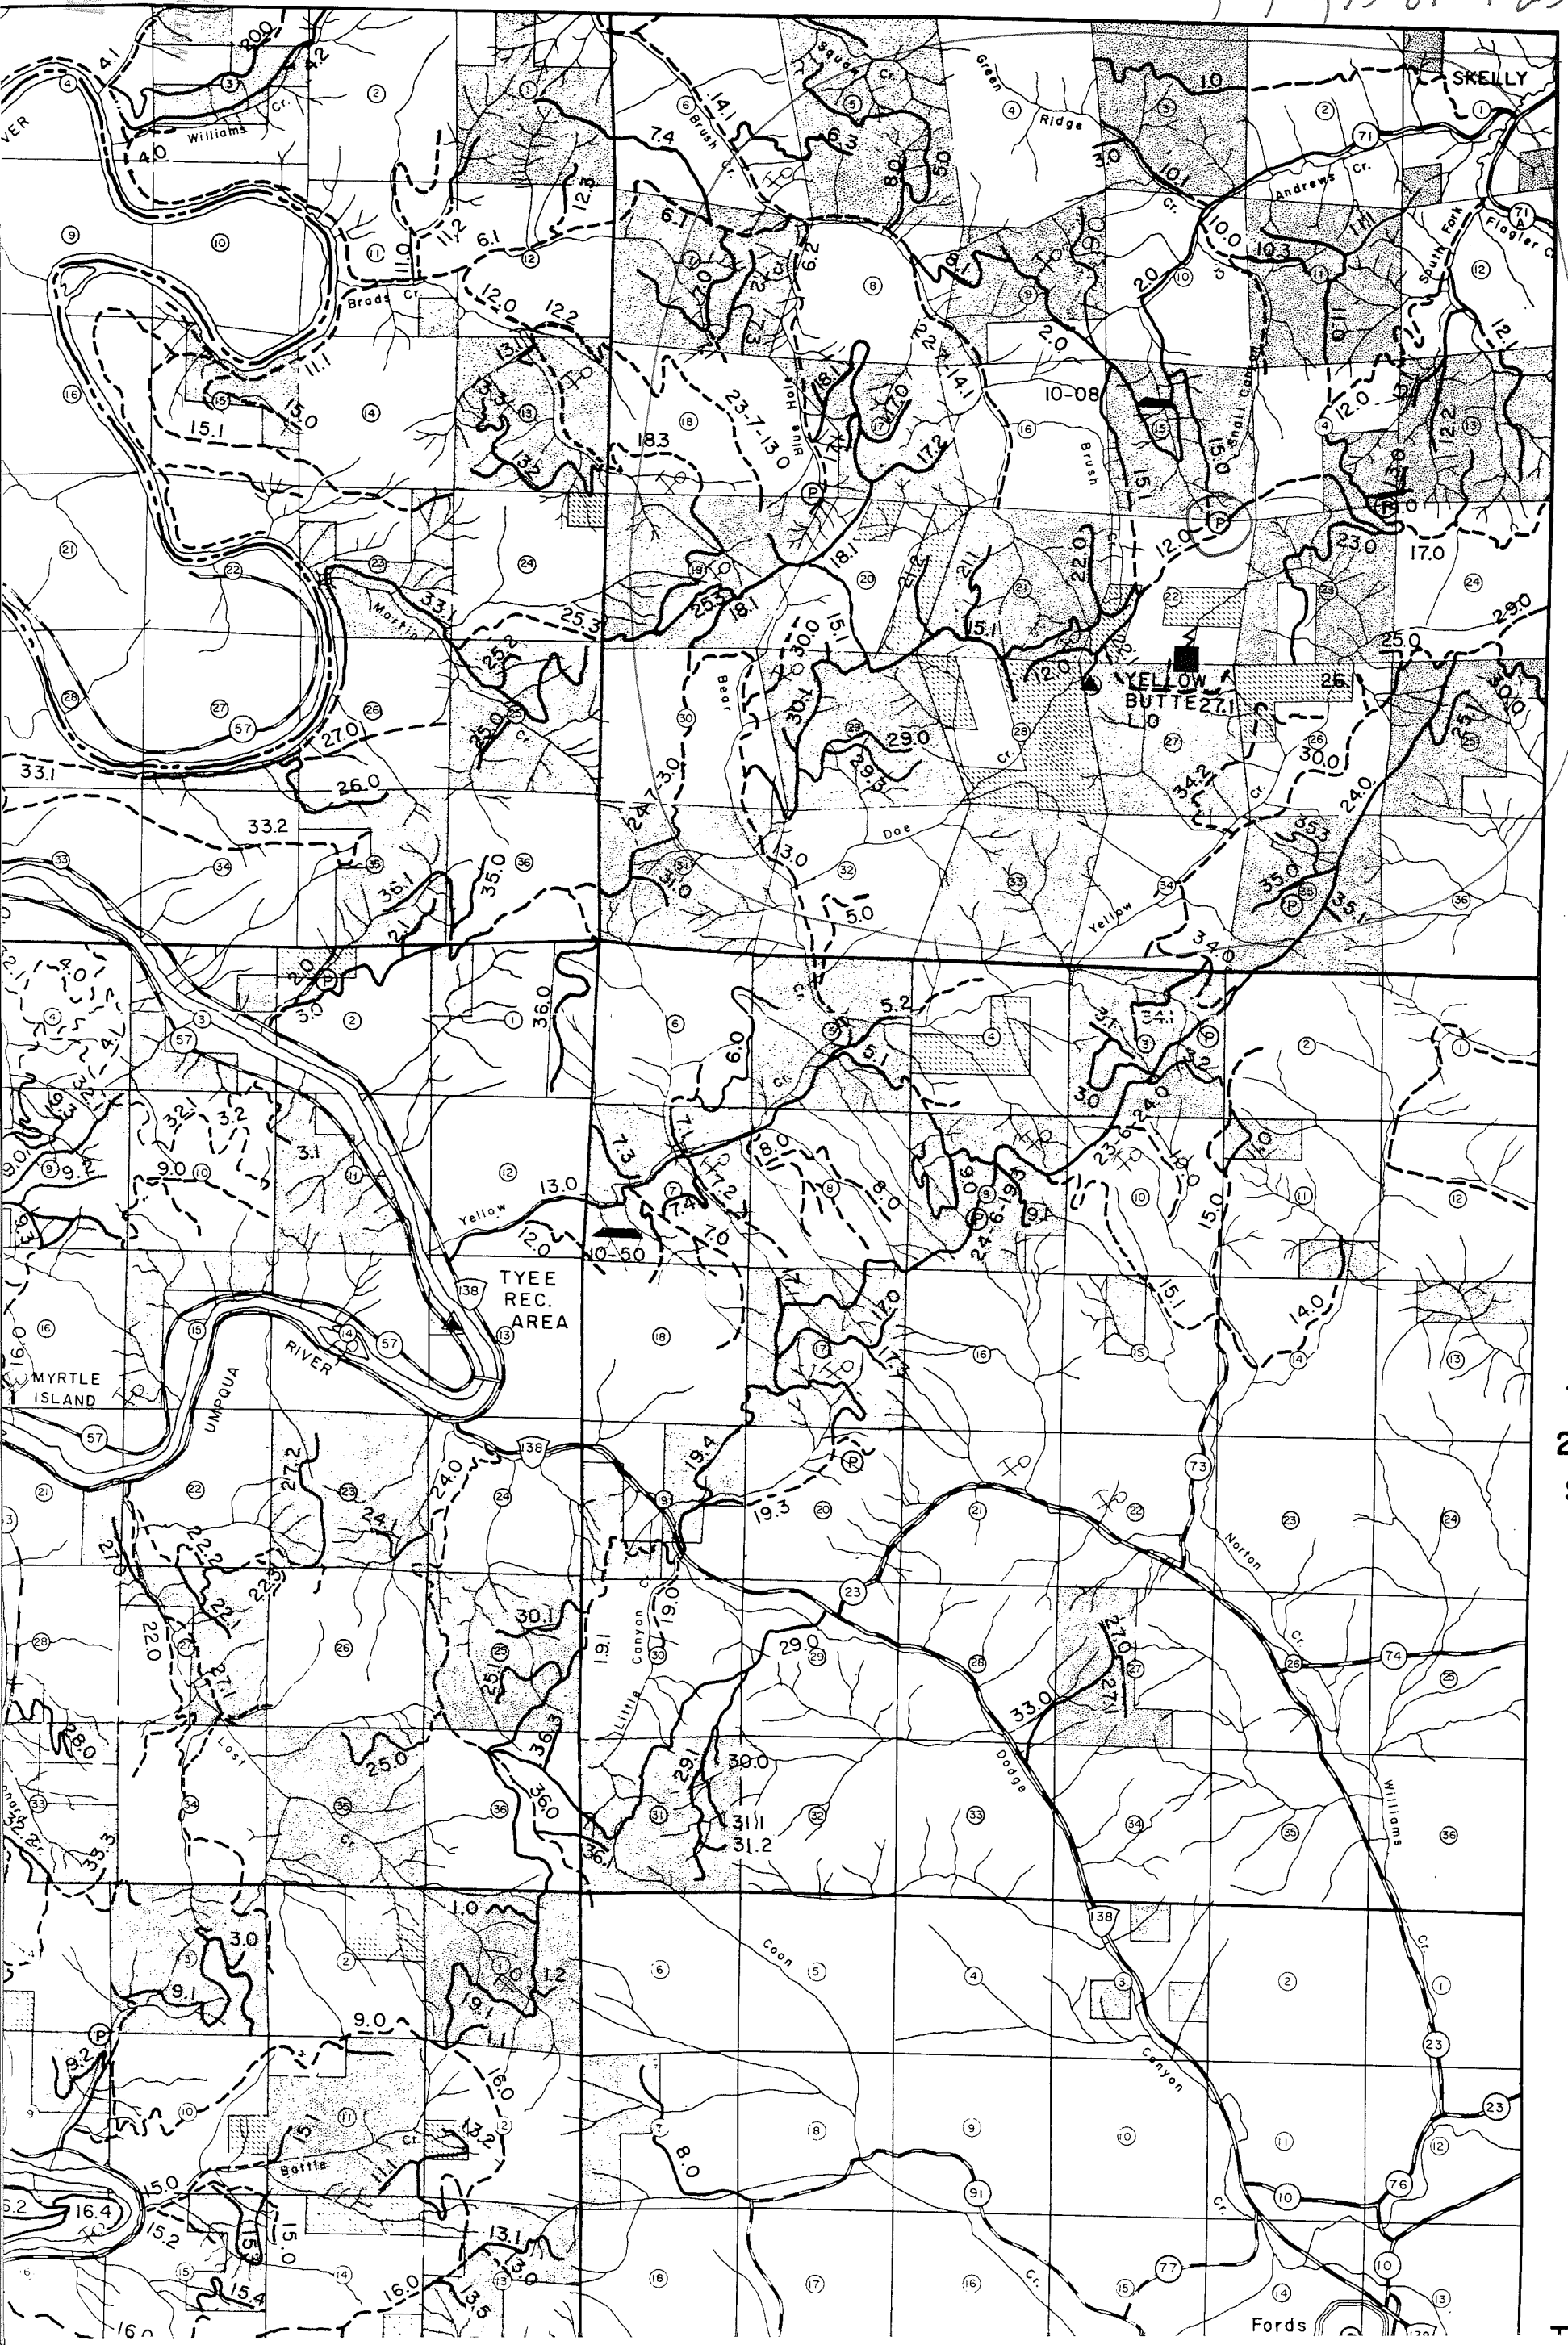

T
23
S

T
24
S

T