Application No. S-76099

Permit No. 52772

WATER RIGHT MAP
IN SEC. 14 T. 17 S., R 3 W., W.M.
LANE COUNTY, OREGON
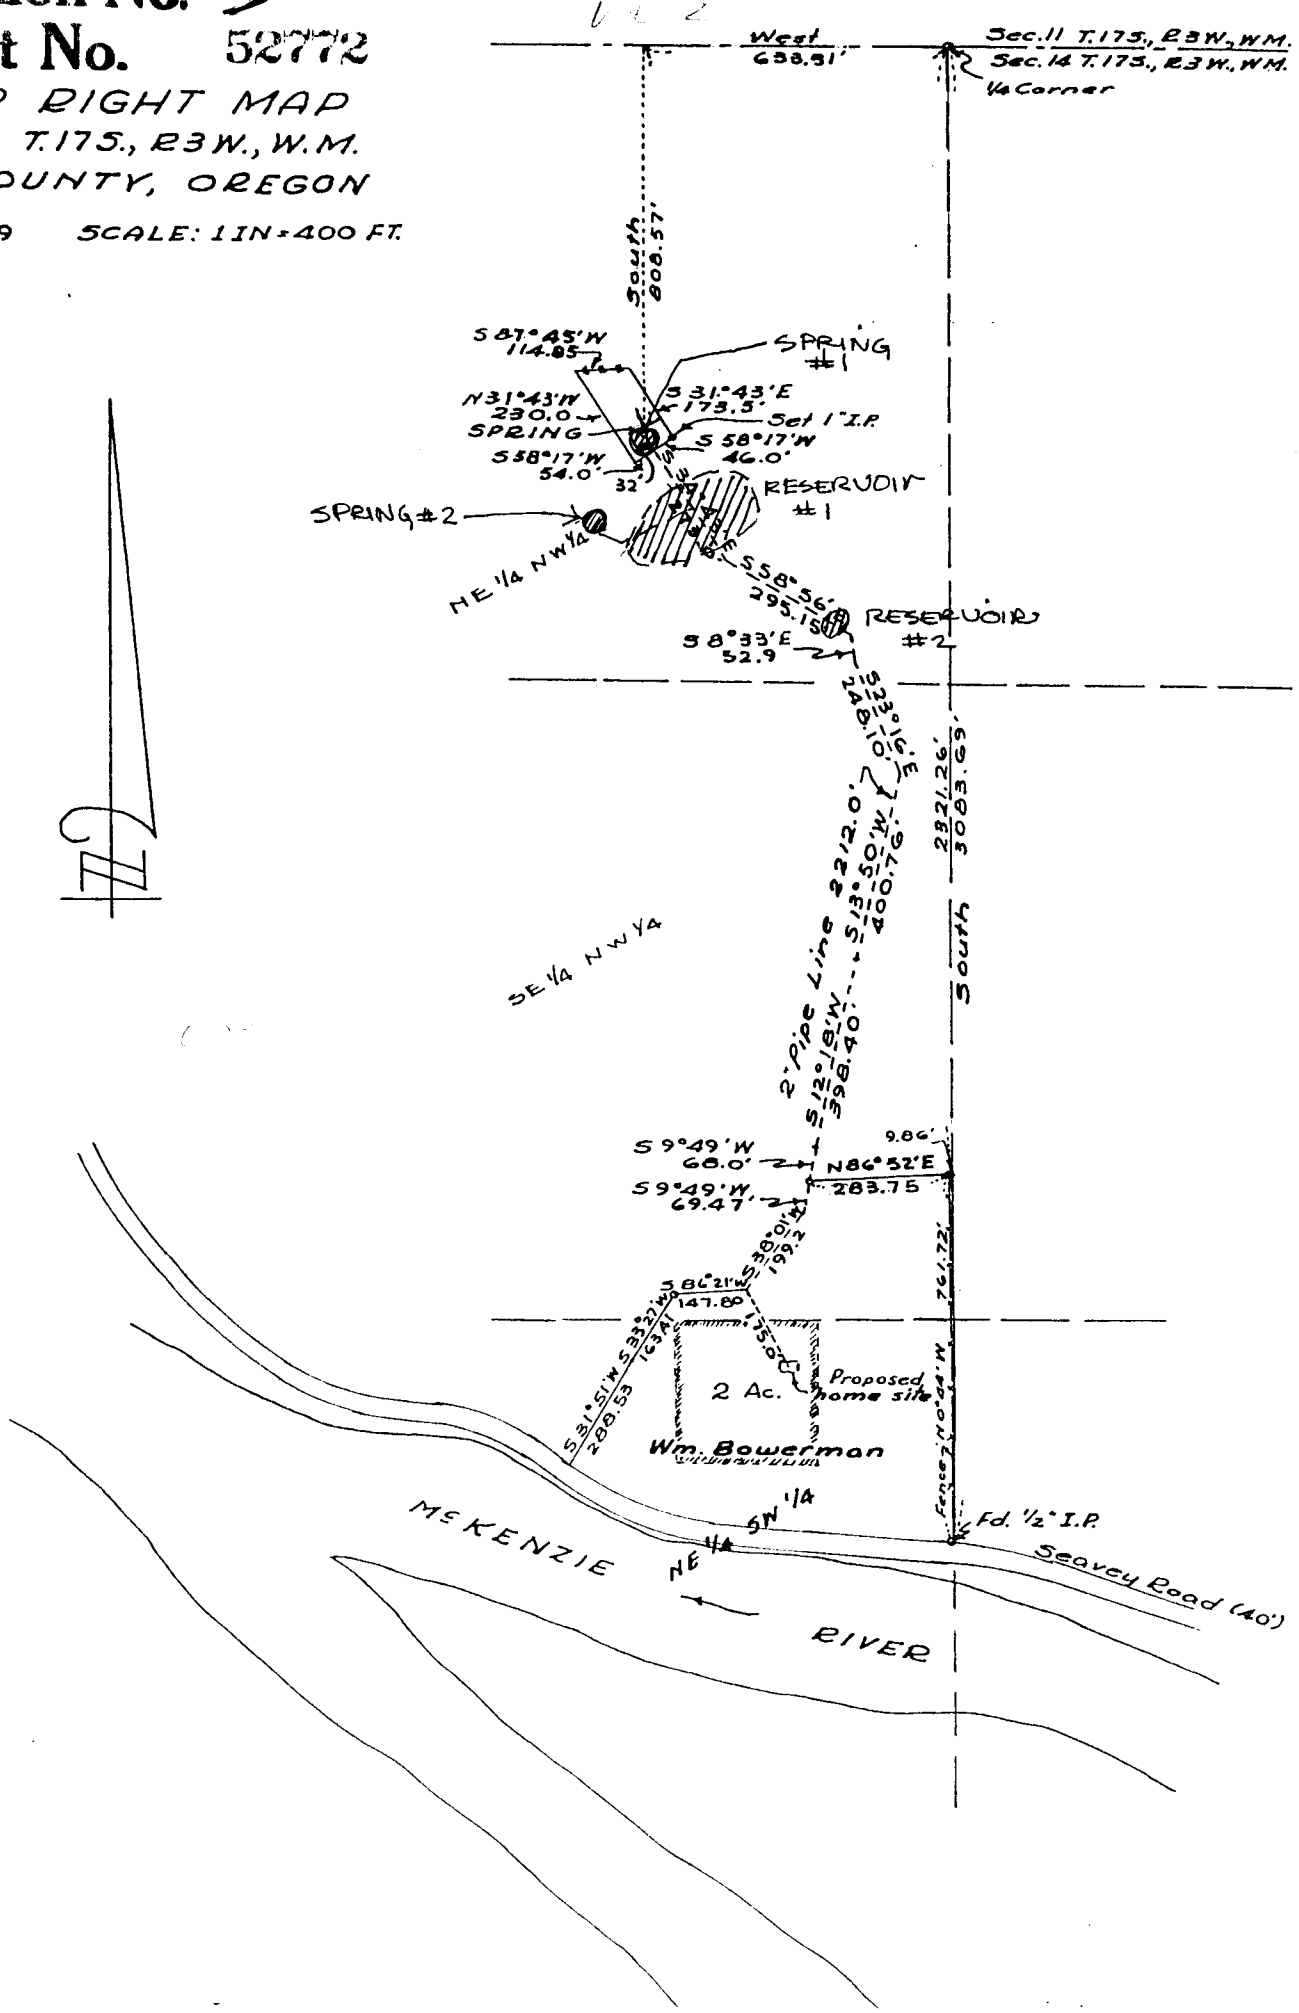
SEPT. 1949 SCALE: 1 IN = 400 FT.