


Application No 72738
 Permit No. 52883

RECEIVED
 SEP 21 1992
 WATER RESOURCES DEPT.
 SALEM, OREGON

T. 19 S., R. 31 E., W.M.

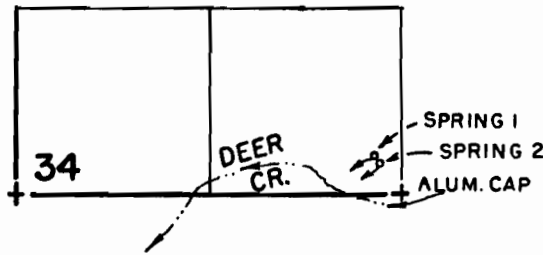


SPRING LOCATIONS FROM S 1/4 CORNER SEC. 34


SPRING 1 - 225' N, 140' W
 SPRING 2 - 180' N, 110' W

THE PURPOSE OF THIS MAP IS TO IDENTIFY THE LOCATION OF THE WATER RIGHT. IT IS NOT INTENDED TO PROVIDE INFORMATION RELATIVE TO THE LOCATION OF PROPERTY OWNERSHIP.

ARTHER & MARILYN WITTRICK

WATER RIGHT APPLICATION MAP

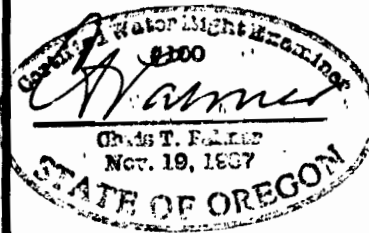

Scale: 4" = 1 MILE	Date: SEPT 1992	Job: 1408
Dsn:	 M. A. PALMER & SONS, INC. ENGINEERING & SURVEYING 254 N. Alder - Box 61 Burns, Oregon 97720	Sht. No.
Drn: CHRIS		of 1
Ckd:		