


Application No. 80933
Permit No. G52917

RECEIVED

FEB 12 1996
WATER RESOURCES DEPT.
SALEM, OREGON

EF
521-700

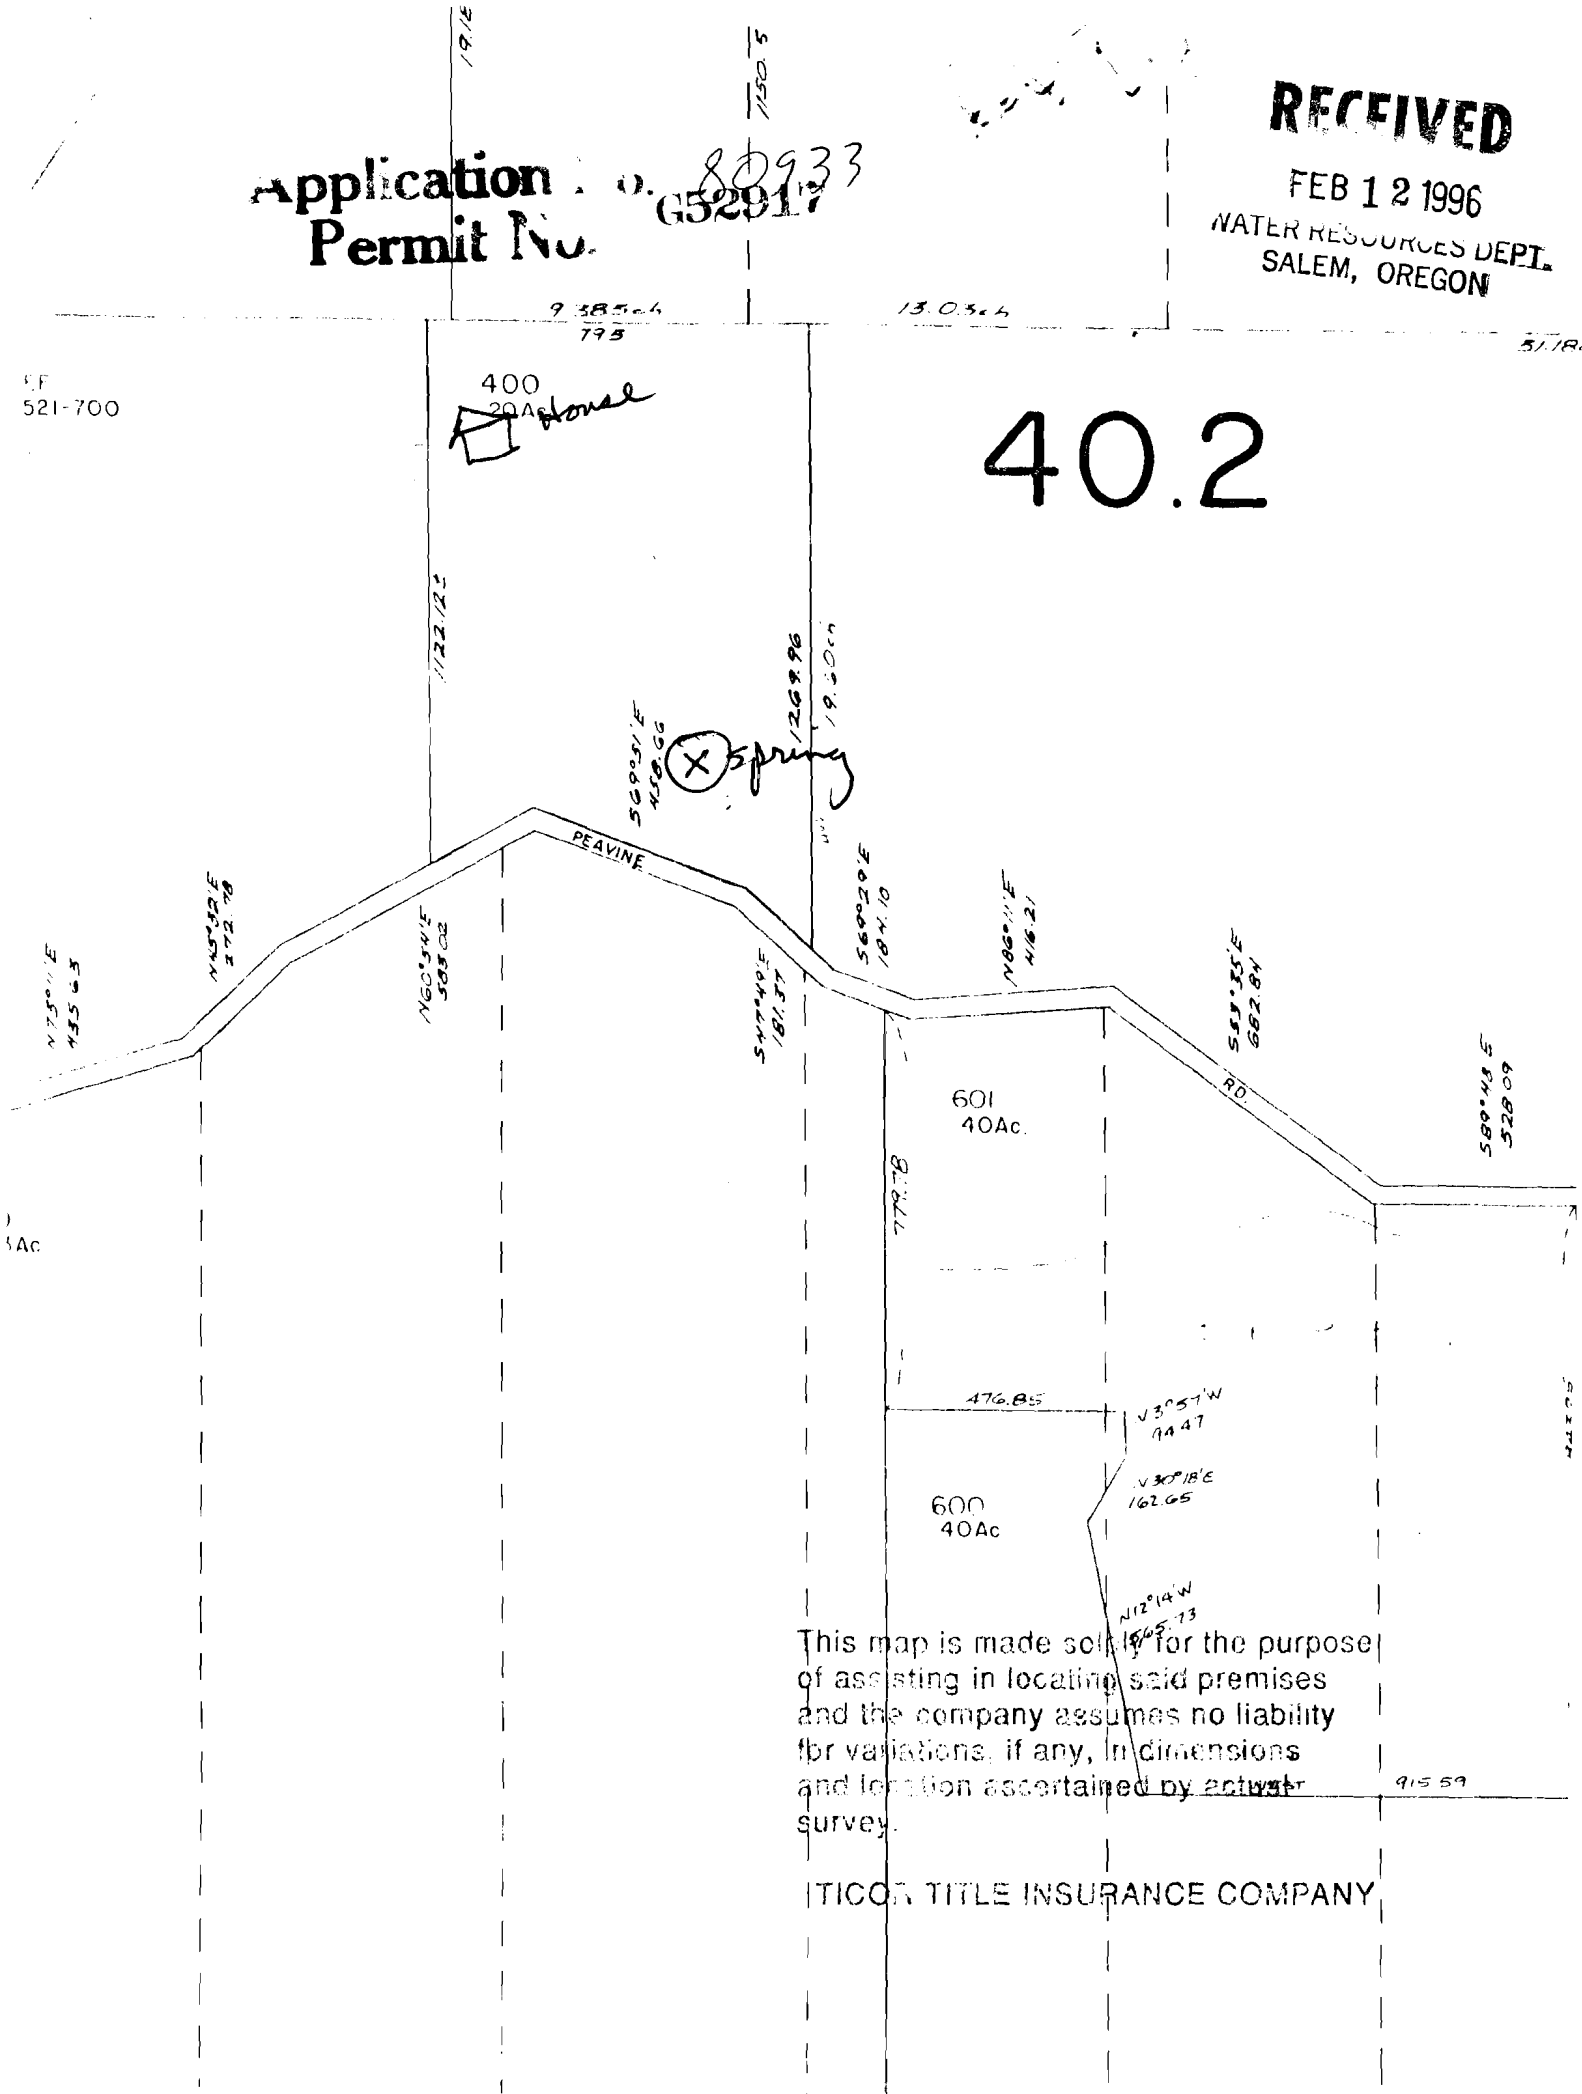

40.2

400
20Ac
House

Spring

PEAVINE

601
40Ac

600
40Ac

This map is made solely for the purpose of assisting in locating said premises and the company assumes no liability for variations, if any, in dimensions and location ascertained by actual survey.

ITICOR TITLE INSURANCE COMPANY

915 59