


C. S. Aikin Evans Creek
Pumping Right

T. 36 S. R. 4 W. W. M.

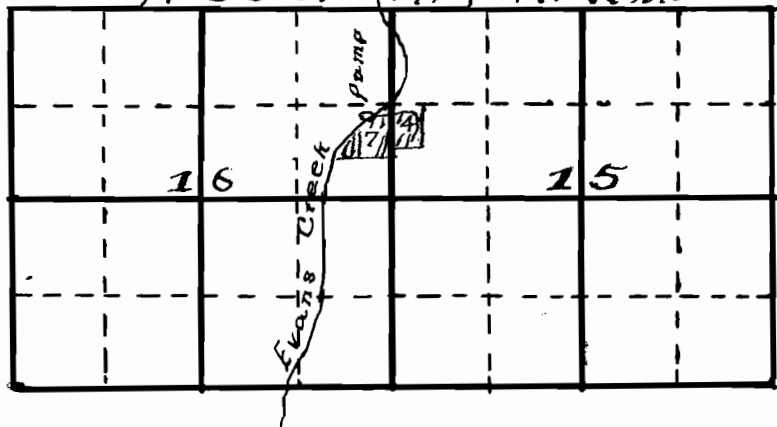

8193
5293