


SCALE 1:2400

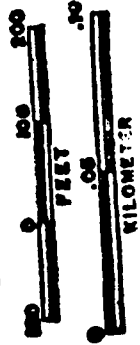


CONTROL LAYOUT CHECKED

RECEIVED OCT 29 1991 DEPT. OF REVENUE STATE OF OREGON

1"=300' SEE MAP 27 12 24B

COOS

27 12 24BC

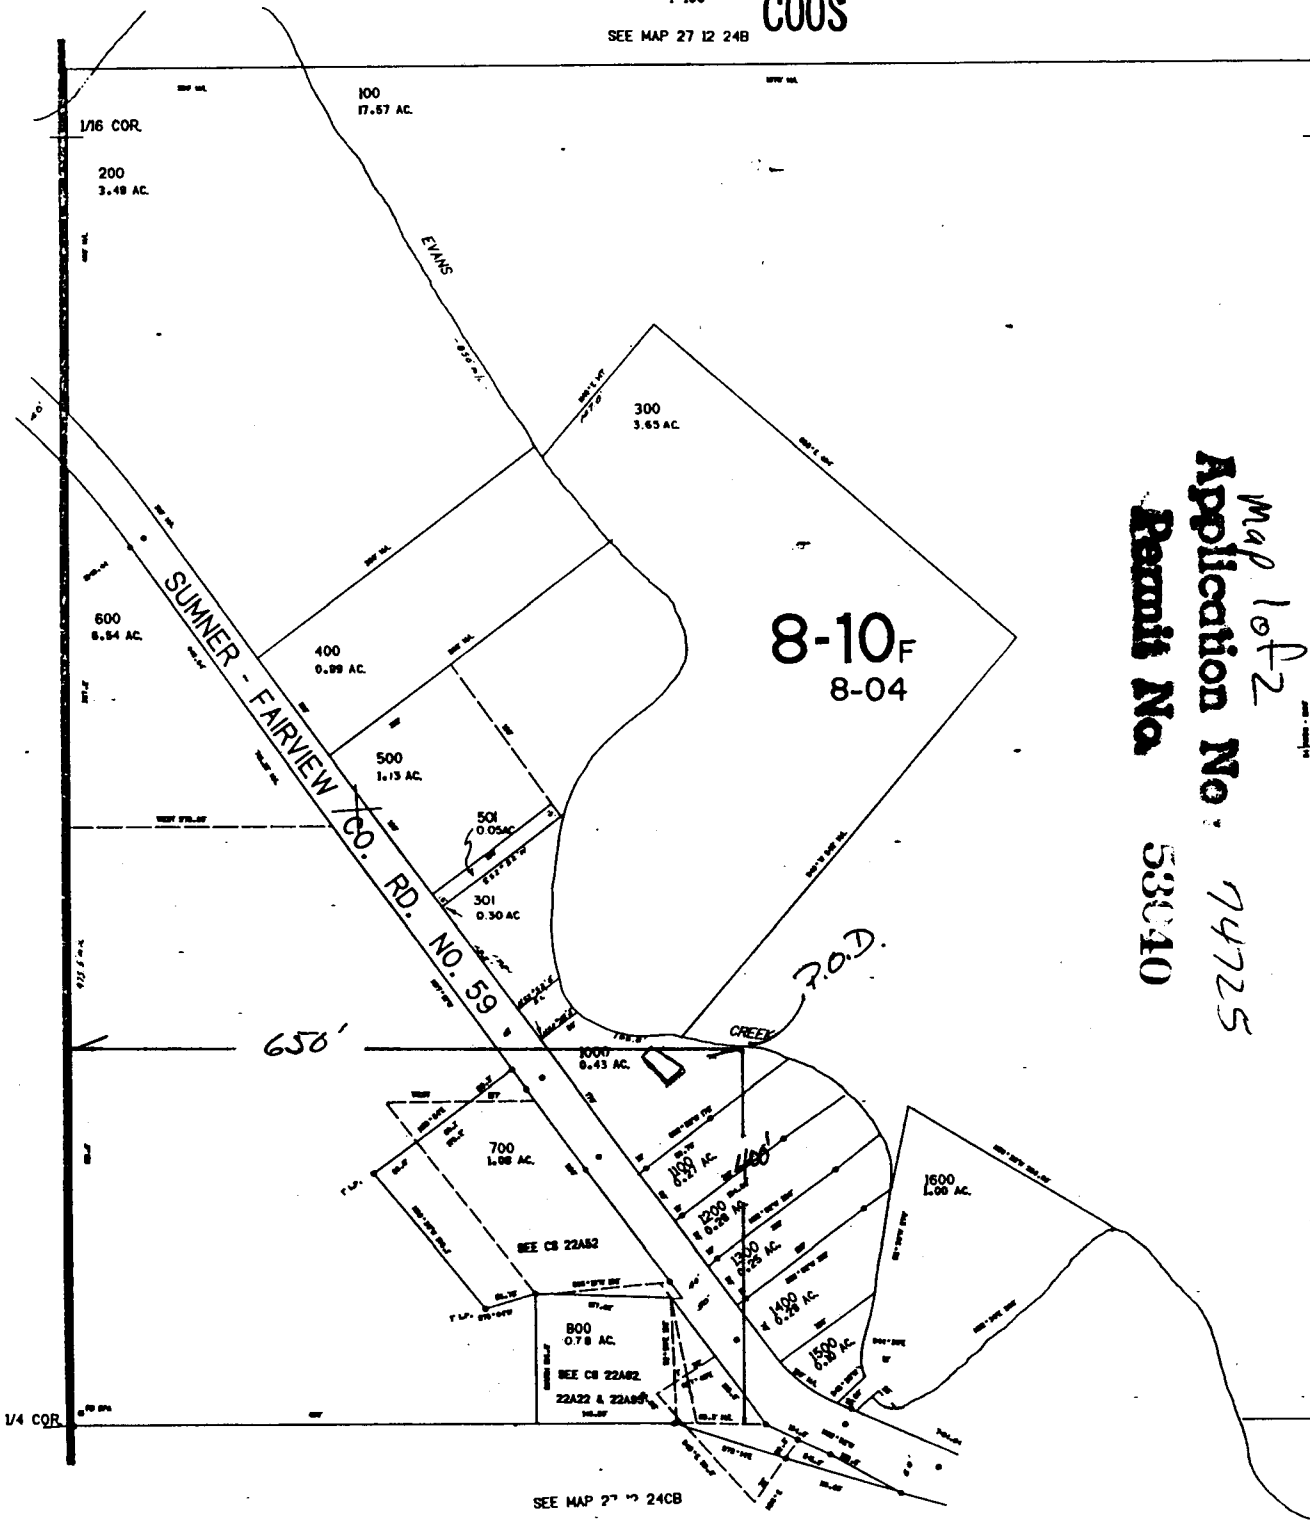

RECEIVED

JUN 06 1996

WATER RESOURCES DEPT. SALEM, OREGON

Map 1 of 2 Application No. 74725 Permit No. 53040

SEE MAP 27 12 24B

586000

SEE MAP 27 12 23

1/16 COR.

1/4 COR.

SEE MAP 27 12 24CB

SEP 26 1991

27 12 24BC

000

SW1/4 NW1/4 SEC. 24 T.27S. R.12W. W.M.  
COOS COUNTY


27 12 24BC

CANCELLED  
900  
1400

1"=100'

SEE MAP 27 12 24B

THIS MAP WAS PREPARED FOR  
ASSESSMENT PURPOSE ONLY.

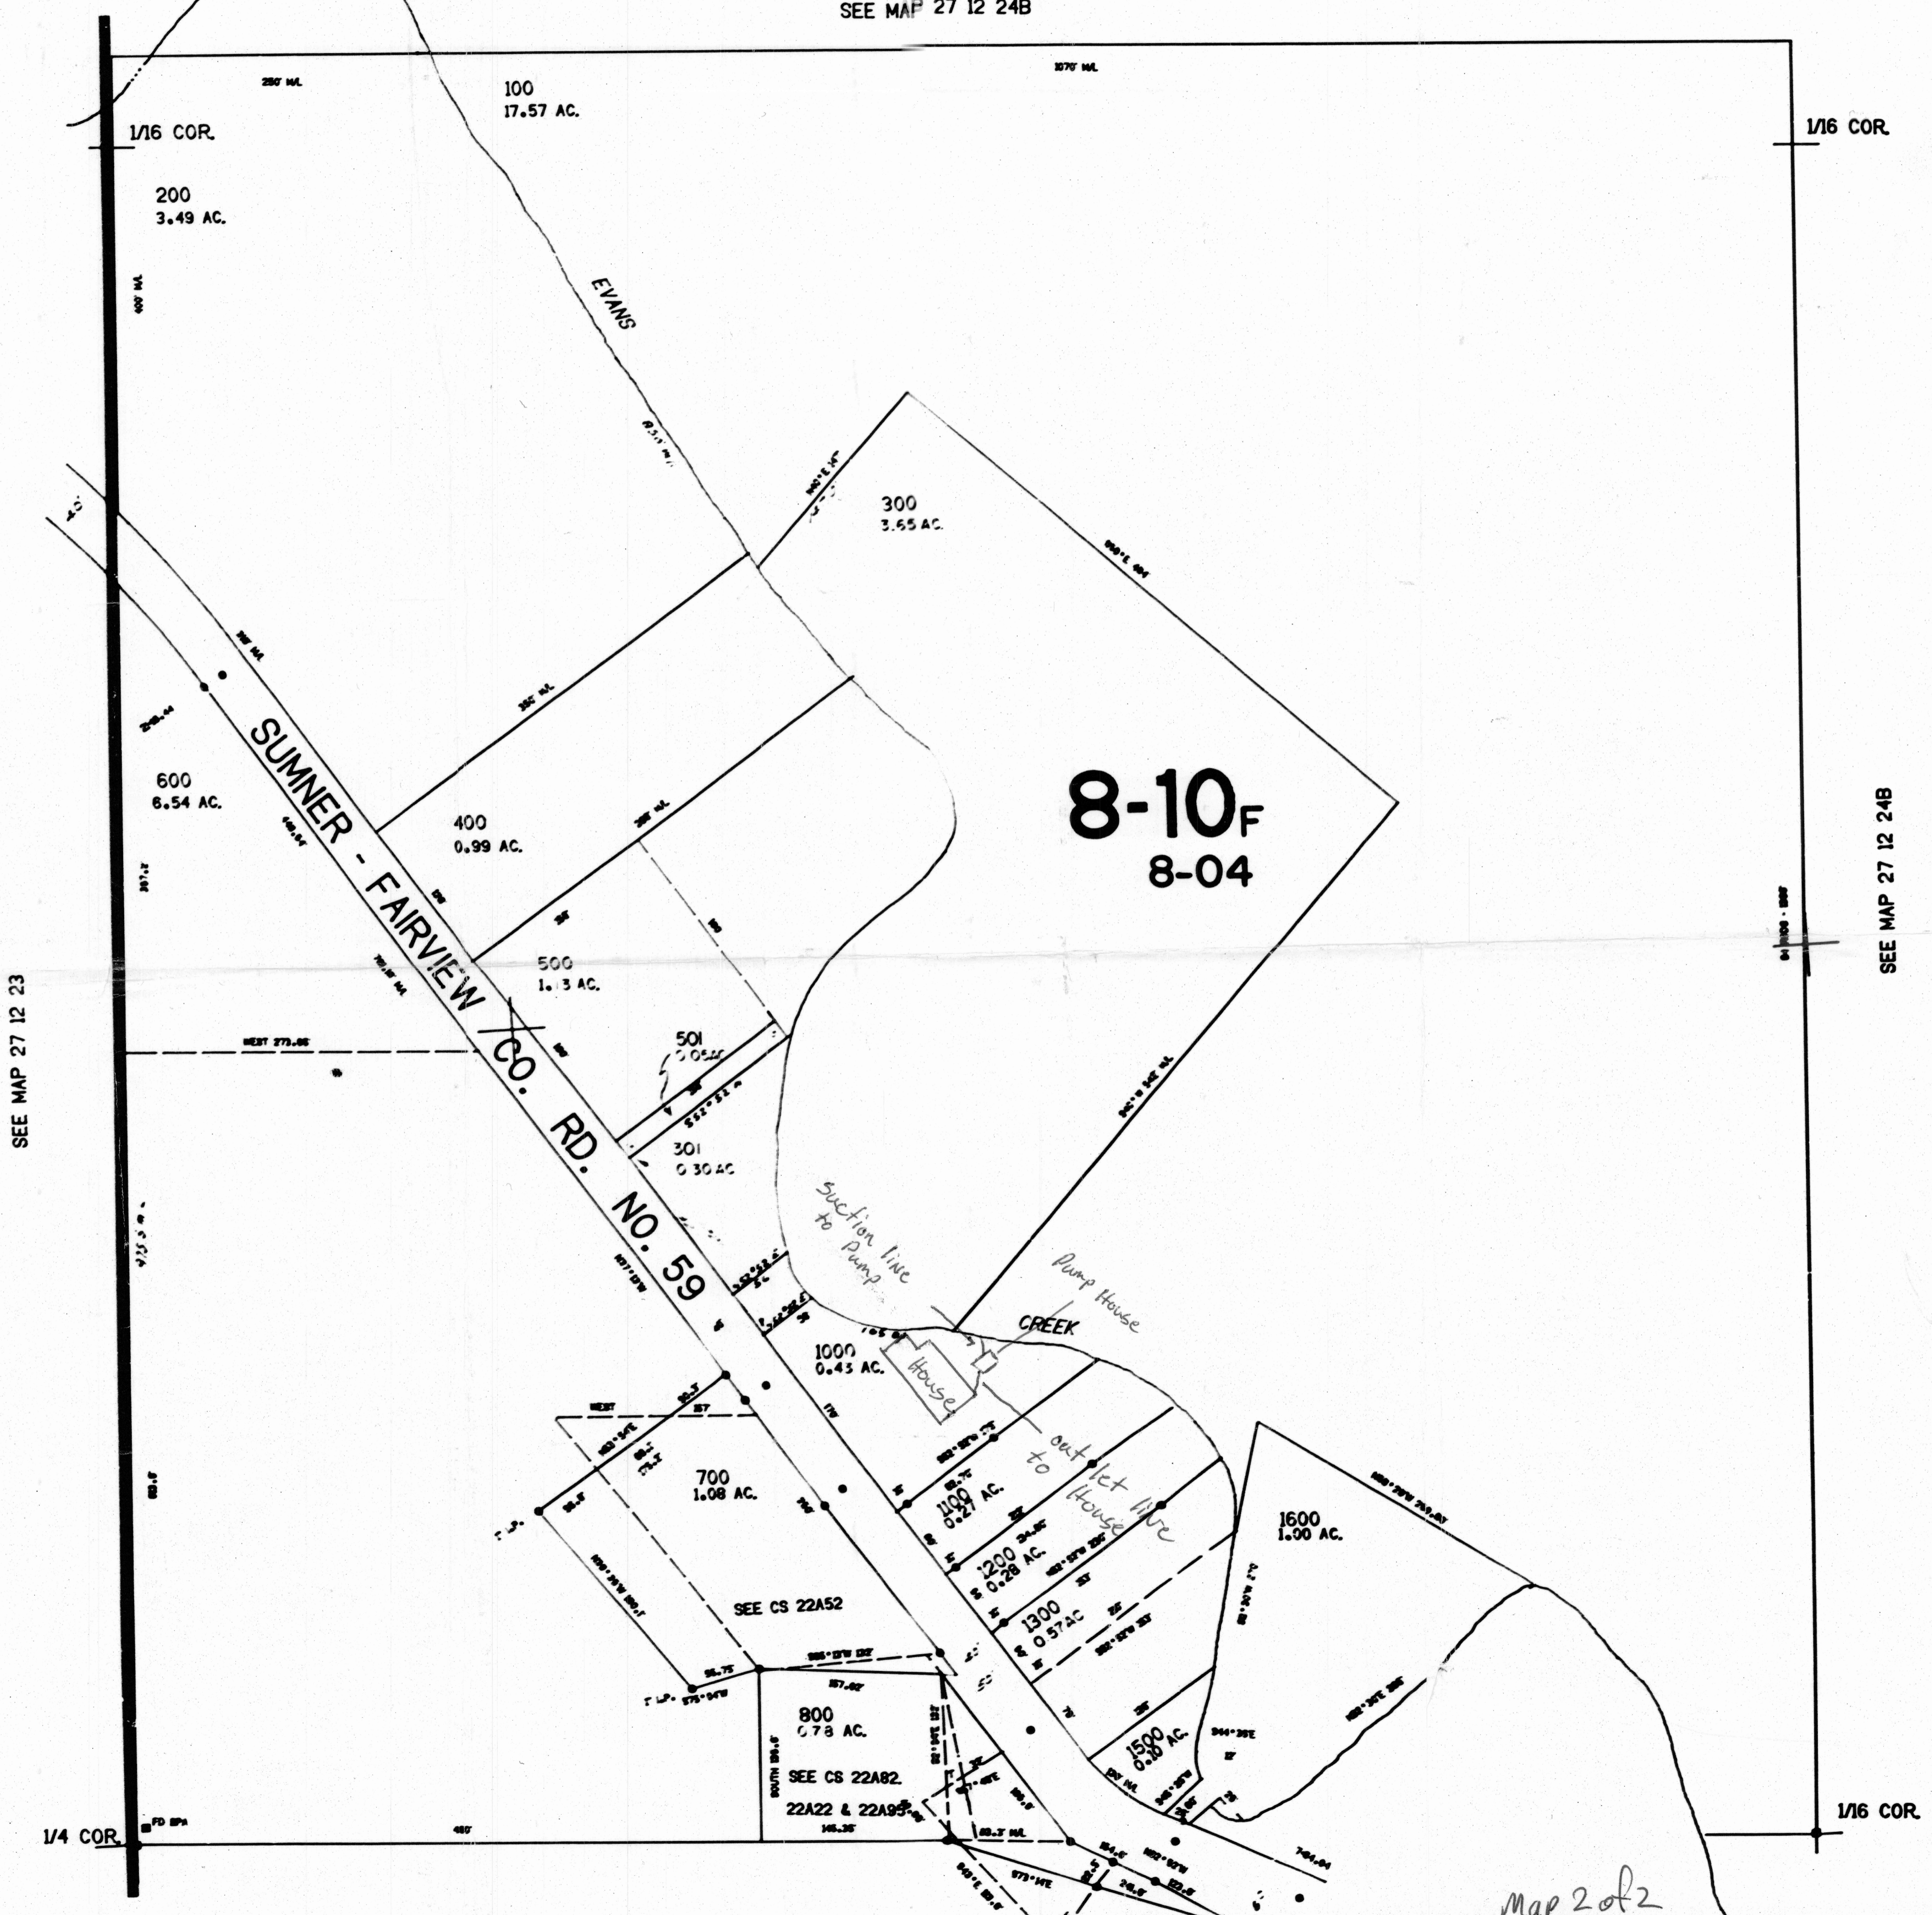

SEE MAP 27 12 23

SEE MAP 27 12 24B

REC  
OCT 1  
WATER RES.  
SALEM,

SEE MAP 27 12 24CB

map 2 of 2  
Application No. 74925

27 12 24B