


RECEIVED

SEP 25 1996

WATER RESOURCES DEPT.
SALEM, OREGON

Section 25 & 26 T.35, R.1E, W.M.

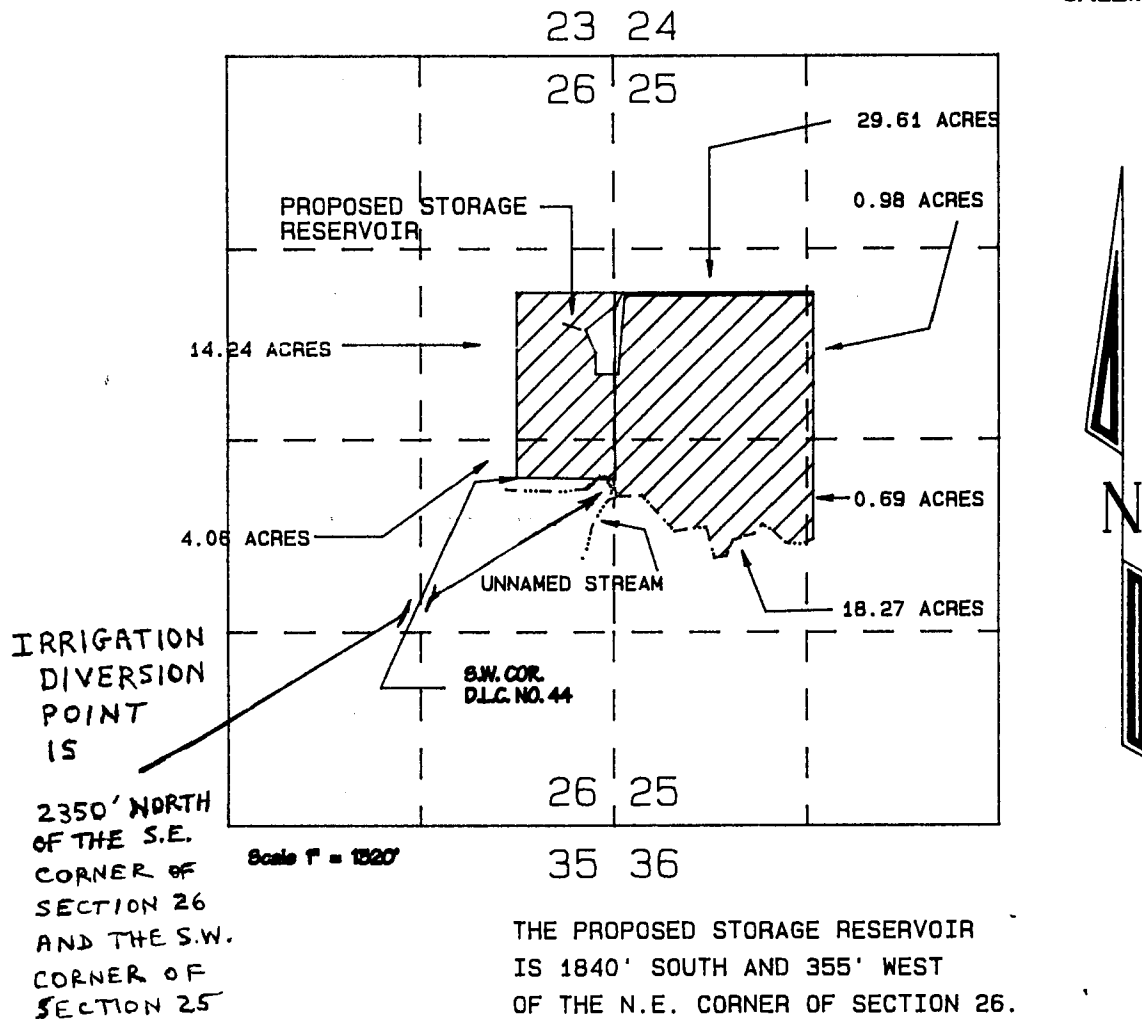

WATER RIGHT APPLICATION MAP
FOR
KENNETH M. & LELYNN K. WILSON

81141
APPLIC. NO. _____ PERMIT NO. 53087

THE PREPARATION OF THIS MAP IS FOR THE PURPOSE OF IDENTIFYING THE LOCATION OF THE WATER RIGHT ONLY AND HAS NO INTENT TO PROVIDE DIMENSIONS OR LOCATION OF PROPERTY OWNERSHIP LINES.