
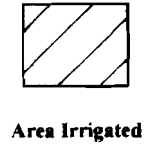


T.3S., R.1W., W.M

RECEIVED
MAR 01 2005
WATER RESOURCES DEPT.
SALEM, OREGON

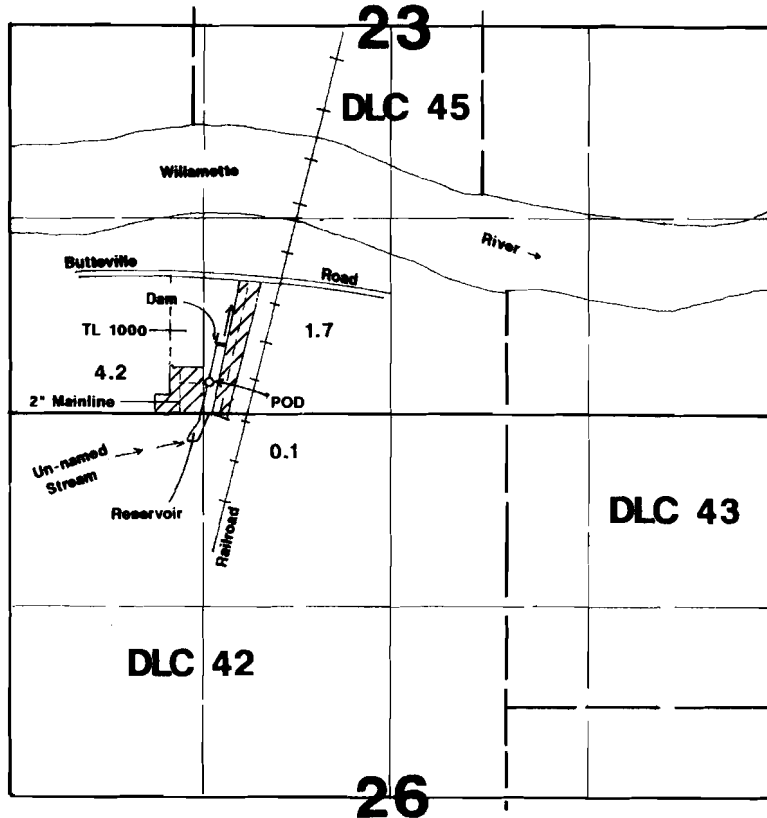

Dam is located 480'N & 1490'E
POD is located 200'N & 1440'E both from the SW corner of Section 23.

Final Proof Survey

In Name Of

David Bernert

**Application #: R-74022
S-78402**

**Permit #: R-12169
53117**

Surveyed on August 11, 2004 by JM Schuette

This Map Was Prepared For The Purpose Of Identifying The Location Of A Water Right Only And Is Not Intended To Provide Legal Dimensions Or Location Of Property Ownership Lines.

