

APPLICATION MAP

IN THE NAME OF: U.S. FISH AND WILDLIFE SERVICE
SECTIONS 17, T 9 S, R 3 W

CONSTRUCTED SUMMER '94"
SURVEYED 10/94

MARION COUNTY


TOTAL SUBMERGED ACREAGE NOT TO EXCEED 114 ACRES
1 INCH = 1320 FEET



RECEIVED

MAY 10 1996

WATER RESOURCES DEPT.
SALEM, OREGON

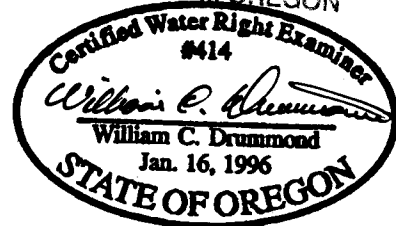

THE PURPOSE OF THIS MAP IS TO IDENTIFY THE
LOCATION OF THE WATER RIGHT. IT IS NOT INTENDED
TO PROVIDE INFORMATION RELATIVE TO THE LOCATION OF
PROPERTY OWNERSHIP BOUNDARY LINES.

Application No. S-80135

Permit No. 53208

Point of Diversion for Sidney Ingoton
West 1930 Feet and North 50 Feet from
East Quarter Corner, Section 34, T9S, R2W.

