

Application No S-81189

Additional info.



Permit No. 53271

RECEIVED


T. 28S.,

R. 6W.,

W.M.

MAY 31 1996

WATER RESOURCES DEPT.
SALEM, OREGON

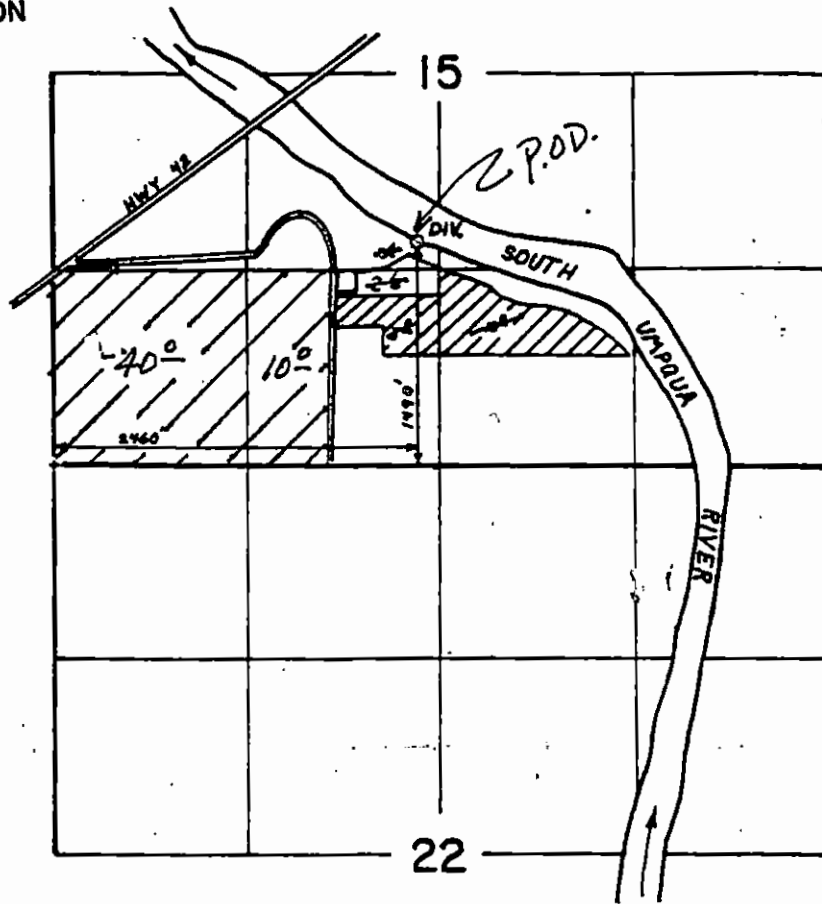

0105742

TAX LOTS 1600, 1700, 1800

* HERE ARE THE ACCES FOR THE QUATER-QUATER SECTIONS
AND THE LOCATION OF THE POINT OF APPROPRIATION.