


Application no. 80987 + R-80988
Permit No. 53274

R12321

FEB 26 1996

WATER RESOURCES DEPT.
SALEM, OREGON

CAN

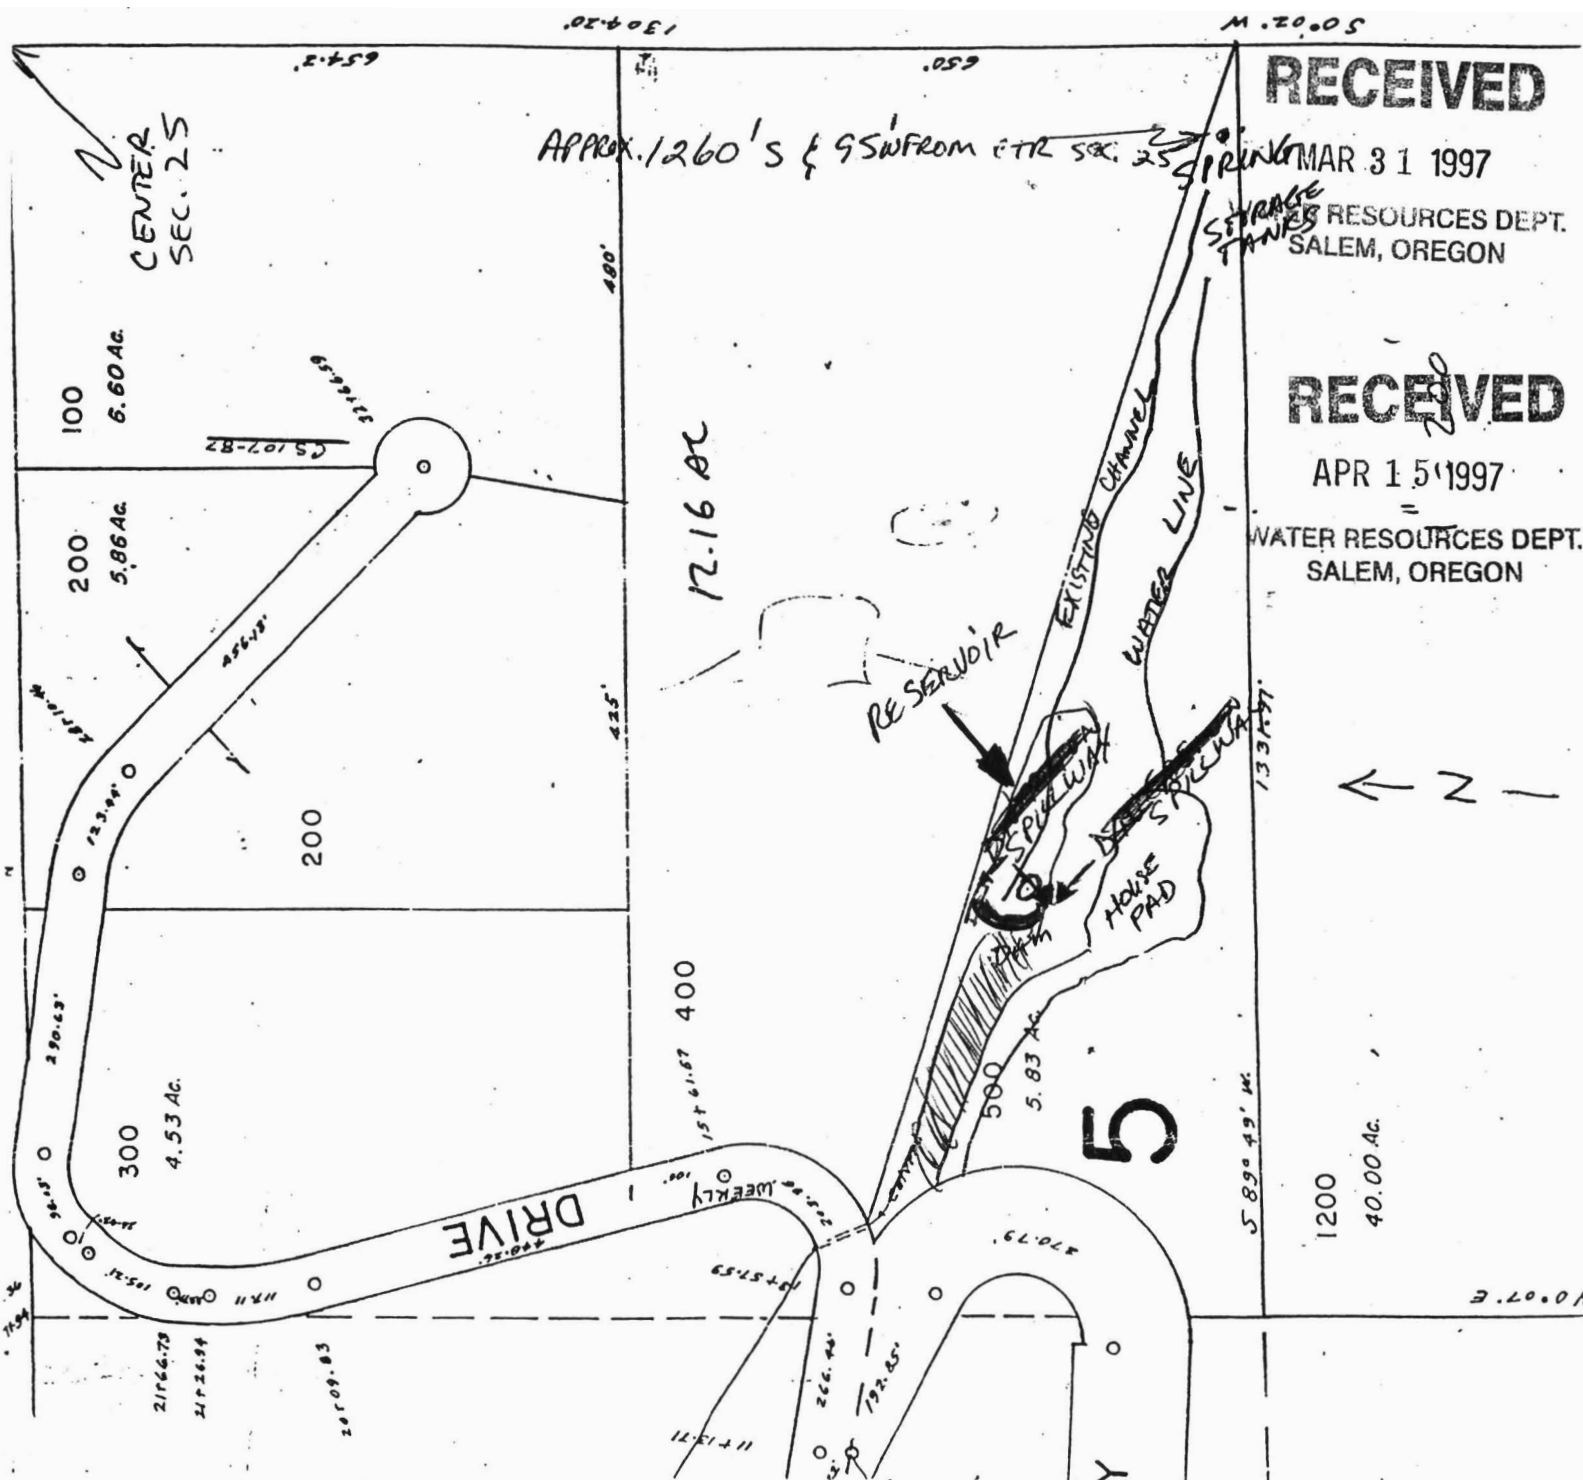

RECEIVED

MAR 31 1997
WATER RESOURCES DEPT.
SALEM, OREGON

RECEIVED

APR 15 1997
WATER RESOURCES DEPT.
SALEM, OREGON

LEGAL DESCRIPTION

36-07-25 TAX LOT 500 - 5.83 ACRES

- IRRIGATED AREA
- POINT OF DIVERSION

NOTE: POD IS APPROX. 1000' S AND 850' W OF CENTER OF SEC. 25.