


Application No. 83392  
Permit No. 53377

T. 26 S. R. 6 W. W.M.

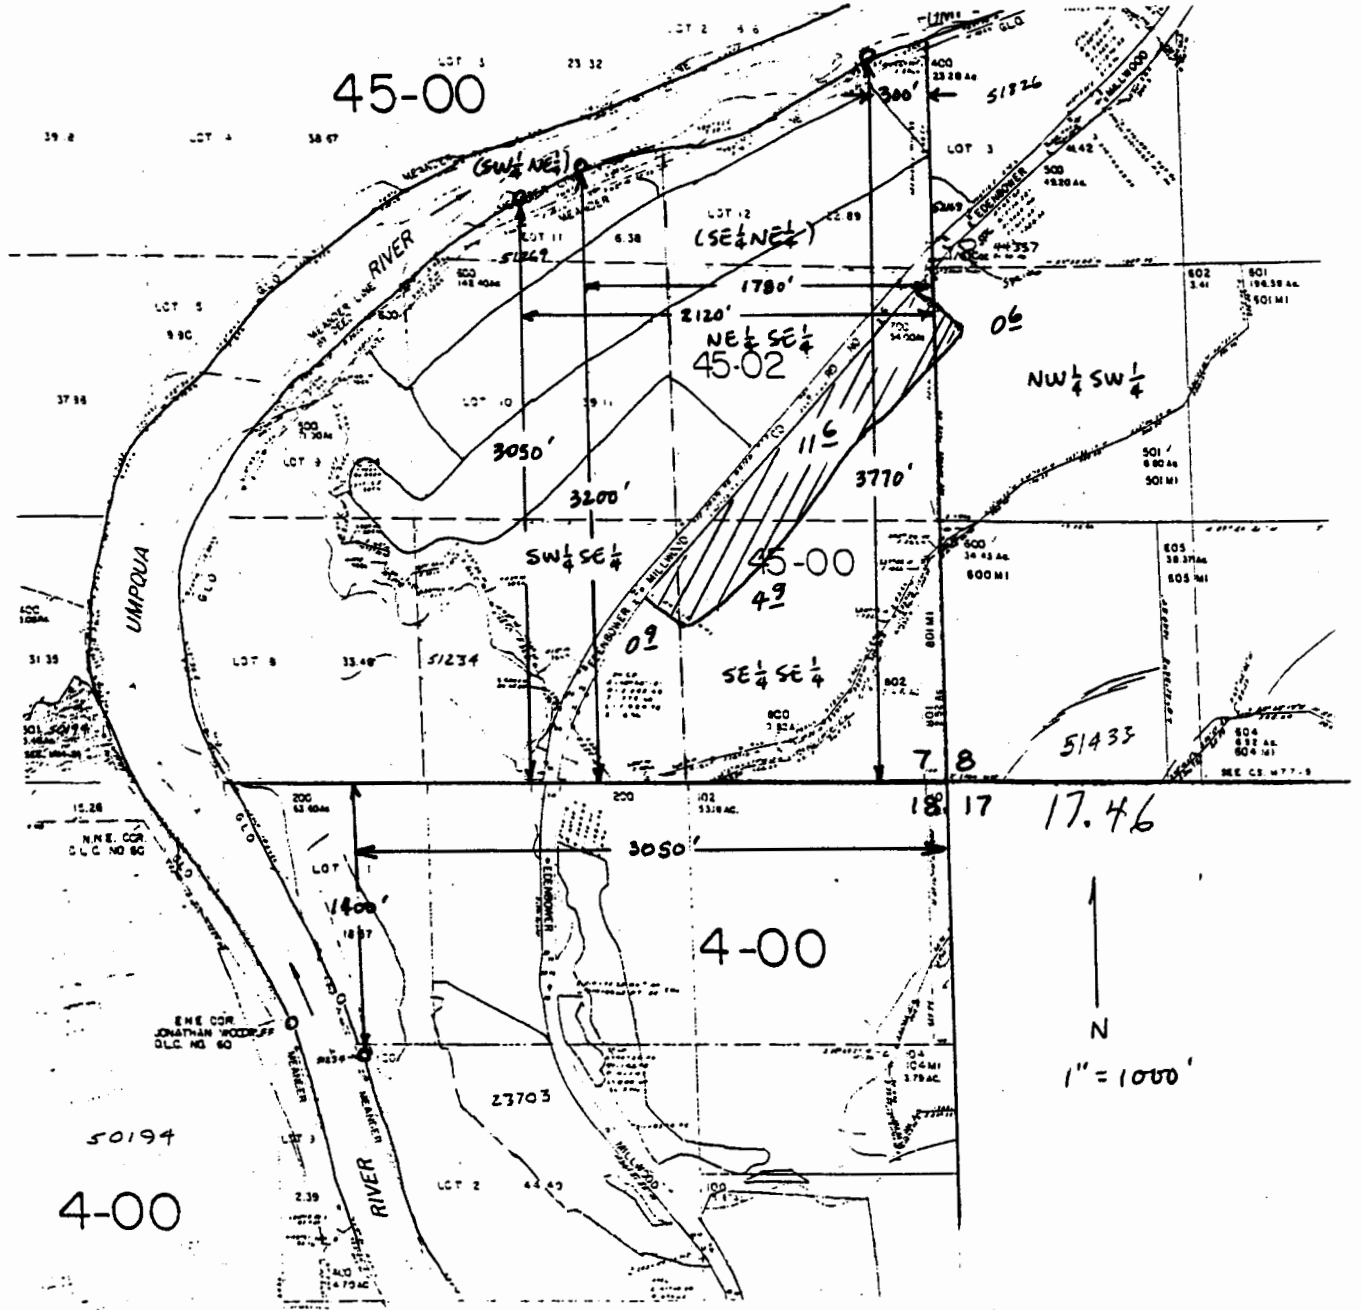

*Handwritten signature or initials*