

RECEIVED

JUL - 3 1997

WATER RESOURCES DEPT.
SALEM, OREGON

RECEIVED


JUL 23 1997

WATER RESOURCES DEPT.
SALEM, OREGON

T.27S., R.6W., W.M.

Application No. 83511

Permit No. 53406

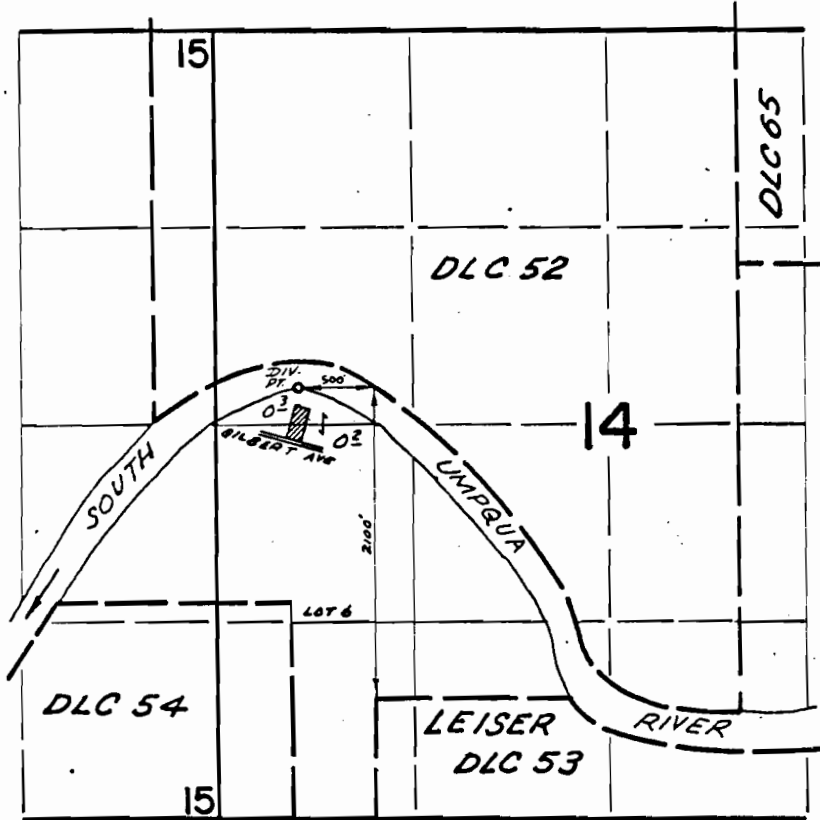

FINAL PROOF SURVEY
UNDER

Application No. 48591 Permit No. 36458

IN NAME OF

FRANCIS L. SULT, M.D.

*William & Elizabeth
Schuyler*

Surveyed Sept 11 1993, by D. Noroy