


# TOWNSHIP 1 SOUTH, RANGE 3 WEST, W.M.

PORTIONS OF SECTION 16  
WASHINGTON COUNTY, OREGON

- 4" BURRIED MAINLINE
- 5" BURRIED MAINLINE
- 6" BURRIED MAINLINE
- 8" BURRIED MAINLINE

31.7  
IRRIGATED ACRES PER  
QUARTER / QUARTER  
SECTION

▲  
POD  
POINT OF DIVERSION

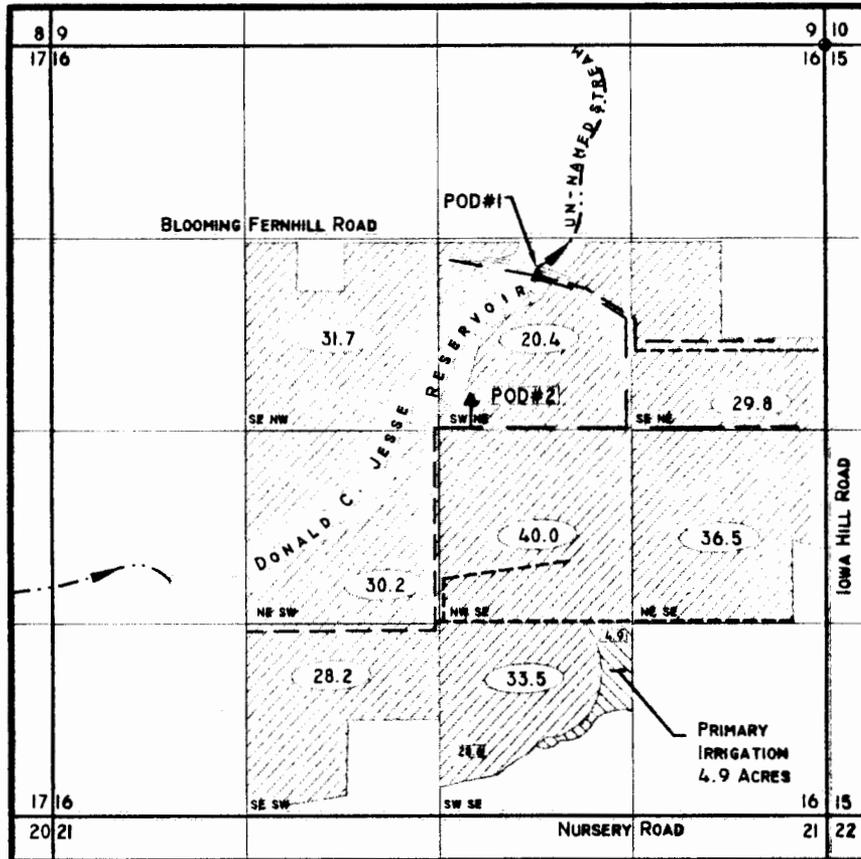

1" = 1320'

P.O.D. #1 LOCATED 1,546 FEET SOUTH AND 1,956 FEET WEST OF THE  
NORTHEAST CORNER OF SECTION 16, T.1S., R3W., W.M.

P.O.D. #2 LOCATED 2,399 FEET SOUTH AND 2,418 FEET WEST OF THE  
NORTHEAST CORNER OF SECTION 16, T.1S., R3W., W.M.

**FINAL PROOF SURVEY**  
UNDER  
APPLICATION NO. 83363, PERMIT NO. 53411

IN THE NAME OF  
**ALAN M. JESSE**  
**JAMES R. FURBY**  
MAY 29, 2001

**RECEIVED**

JUN 11 2001

WATER RESOURCES DEPT  
SALEM, OREGON

SOURCE OF WATER: DONALD C. JESSE RESERVOIR  
PERMIT NO. R-12479 LOCATED ON AN UN-NAMED  
STREAM TRIBUTARY TO THE TUALATIN RIVER.

ALL ACREAGE IS SUPPLEMENTAL IRRIGATION WITH  
THE EXCEPTION OF 4.9 ACRES IN THE SW 1/4 & SE 1/4  
SECTION 16 WHICH IS PRIMARY.



Expires 6/30/2001

THIS MAP WAS PREPARED FOR THE PURPOSE OF  
IDENTIFYING THE LOCATION OF WATER RIGHT(S) ONLY  
AND IS NOT INTENDED TO PROVIDE LEGAL DIMENSIONS OR  
LOCATION OF PROPERTY OWNERSHIP LINES.